


W Face of wall end line

HAMPDEN AVE

P.F. Francis Allyn

BRADFORD
390.30

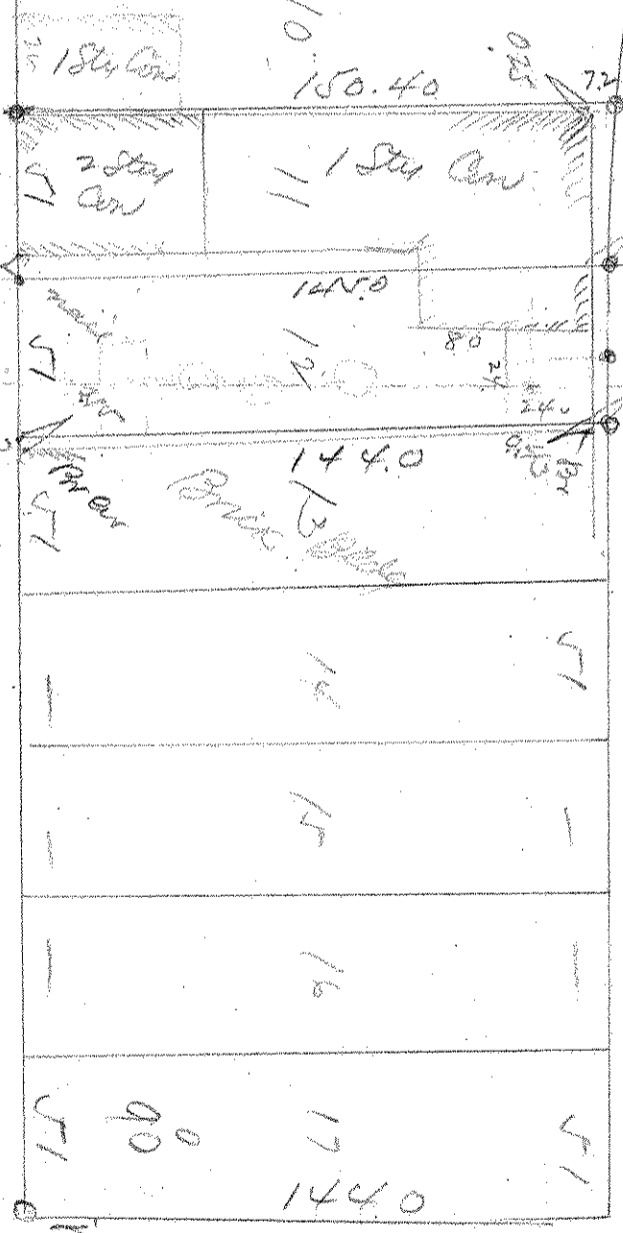

Head