
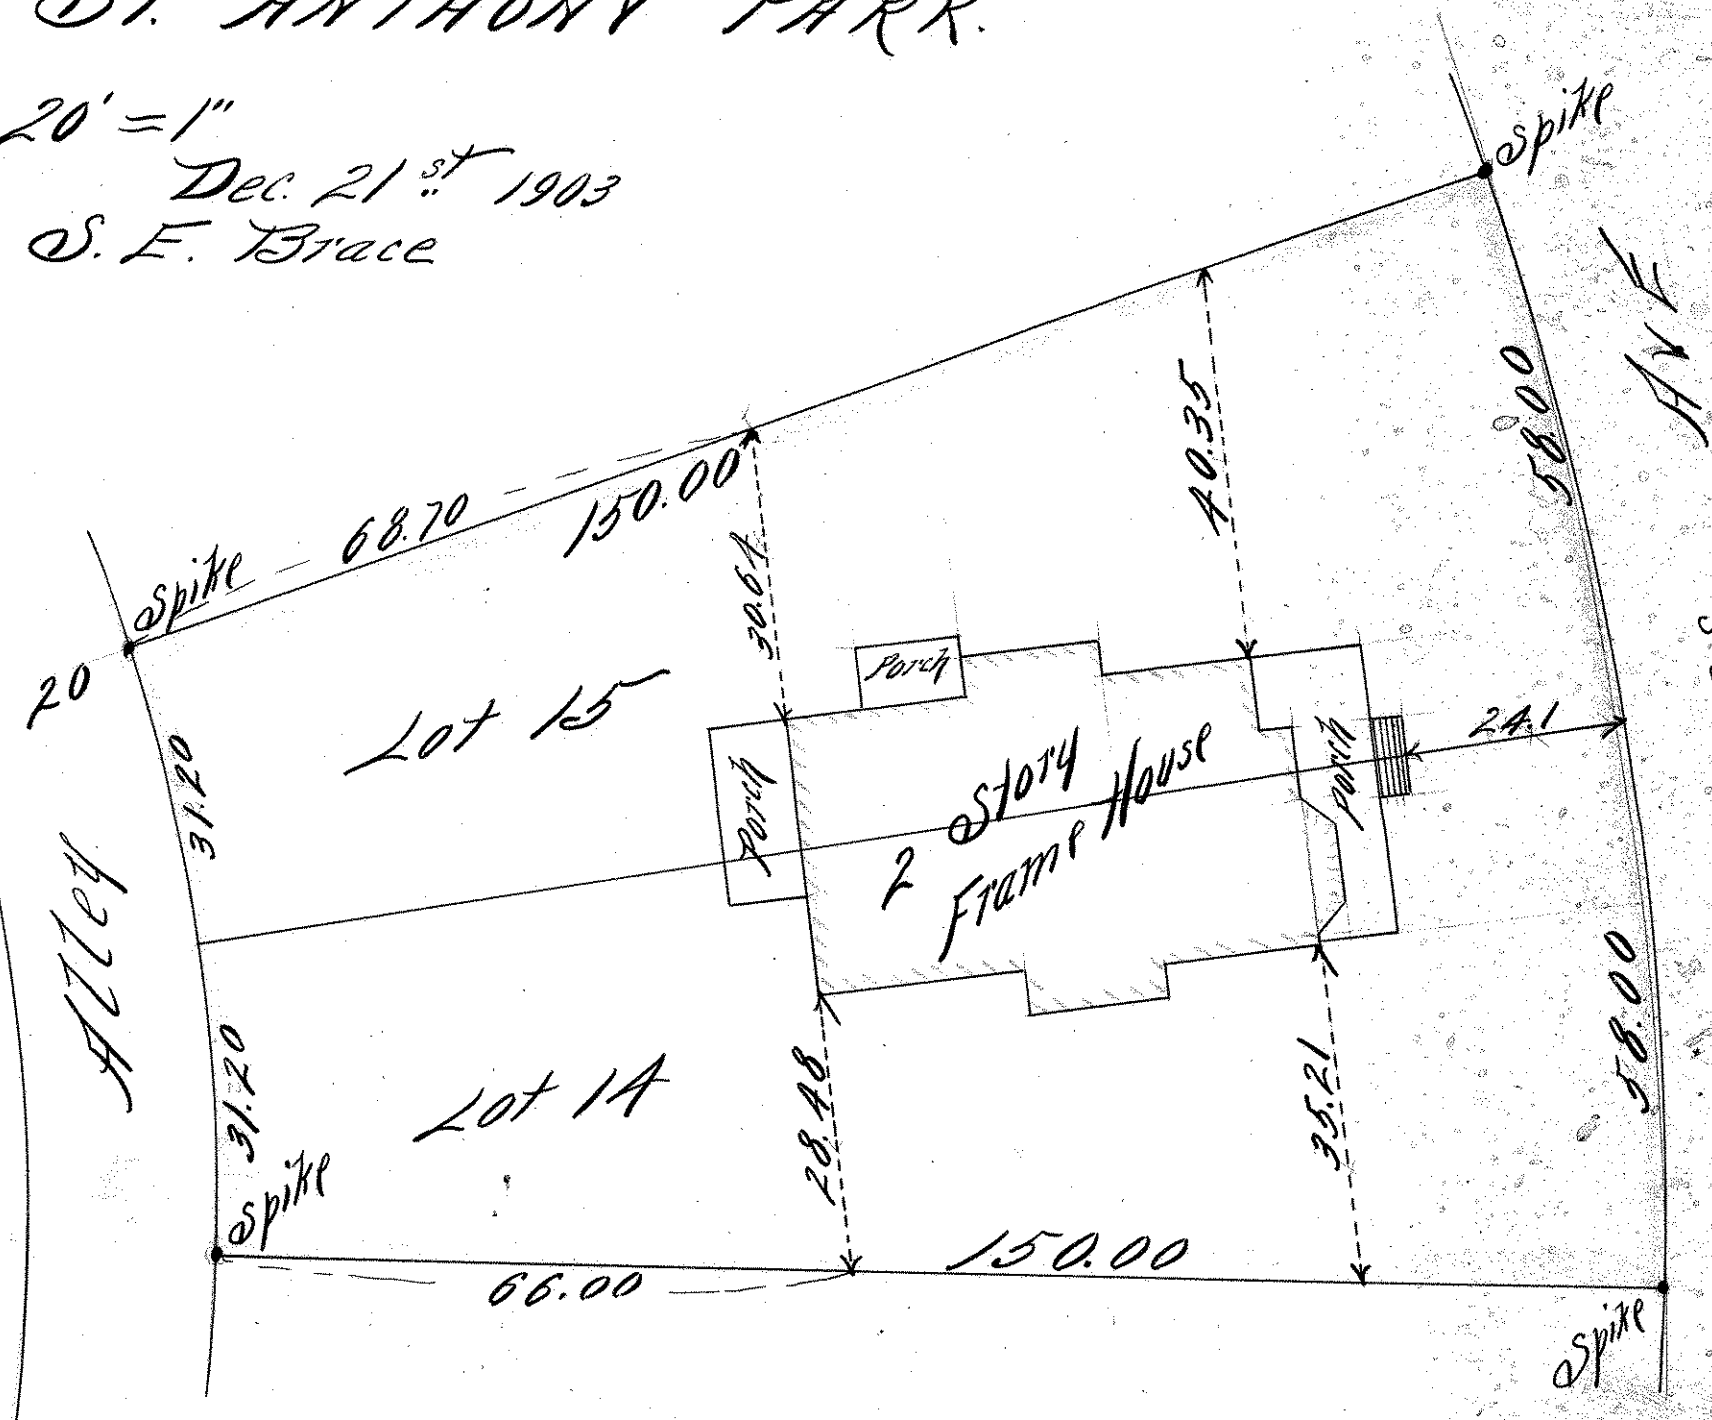


LOTS 14 & 15 BLOCK 76  
ST. ANTHONY PARK.

20' = 1"

Dec. 21<sup>st</sup> 1903

S. F. Brace

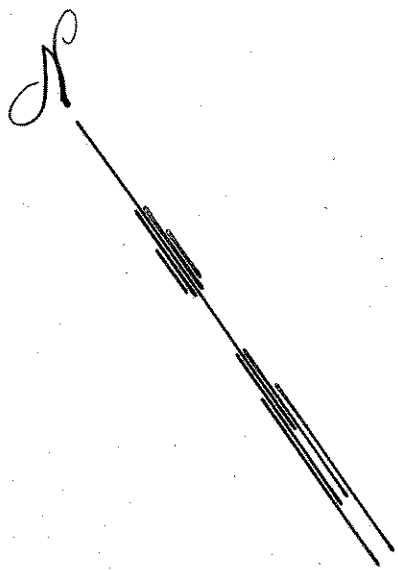

BAYLESS AVE