

FROM THE OFFICE OF

CHARLES O. GEORGI COMPANY

2215 West County Road B

Saint Paul, Minnesota 55113

REGISTERED CIVIL ENGINEER AND LAND SURVEYOR

Certificate of Survey

I Hereby Certify that this plat shows a survey made by me of the property described on this plat, and that the corners are correctly placed as shown, and that all locations have been correctly shown.

Surveyed For D.D. WOZNIAK

Date July 1976


Scale 1" = 40'

By Charles O. Georgi
REGISTERED LAND SURVEYOR

Description:

The North 50 feet of Lots 15 and 16, Block 77, St. Anthony Park, Ramsey County, Minnesota and also, The North 1/3 of Lots 15 and 16, Block 77, St. Anthony Park, Ramsey County, Minnesota.

Note: We could find no overlap or gap between the above descriptions

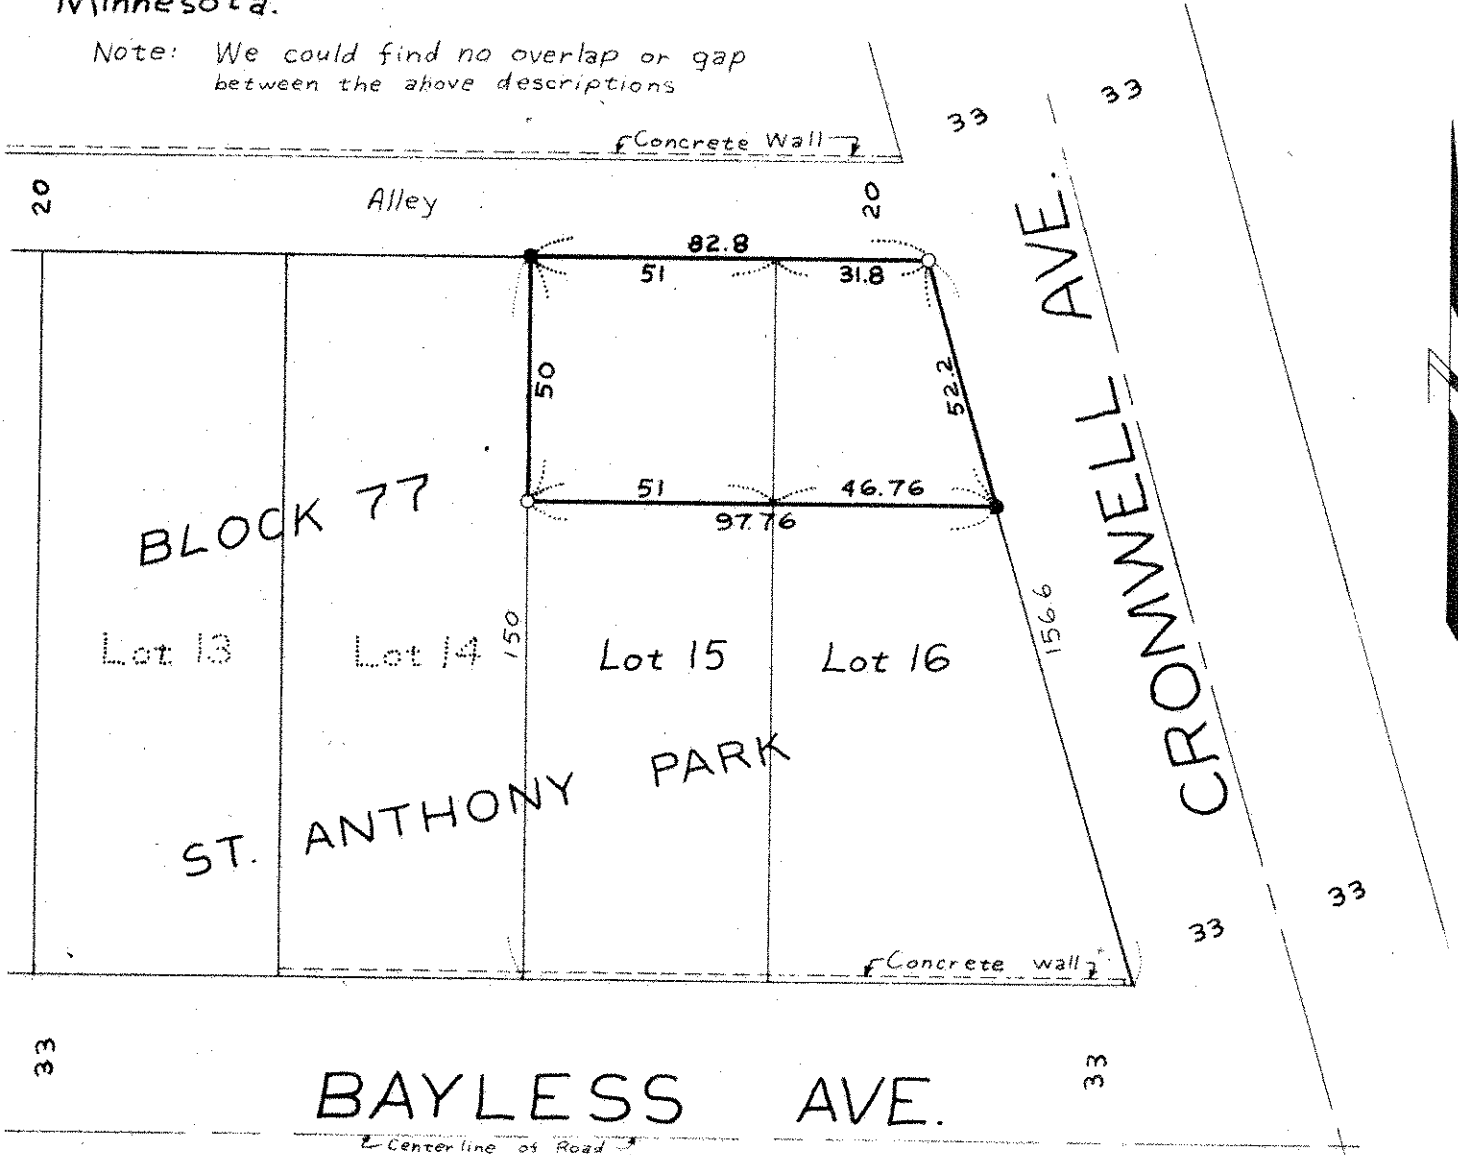

○ Denotes Iron Pipe Monument
● Denotes Iron Pipe Monument Found in Place