LOT 17 BLOCK 77

ST ANTHONY PARK.
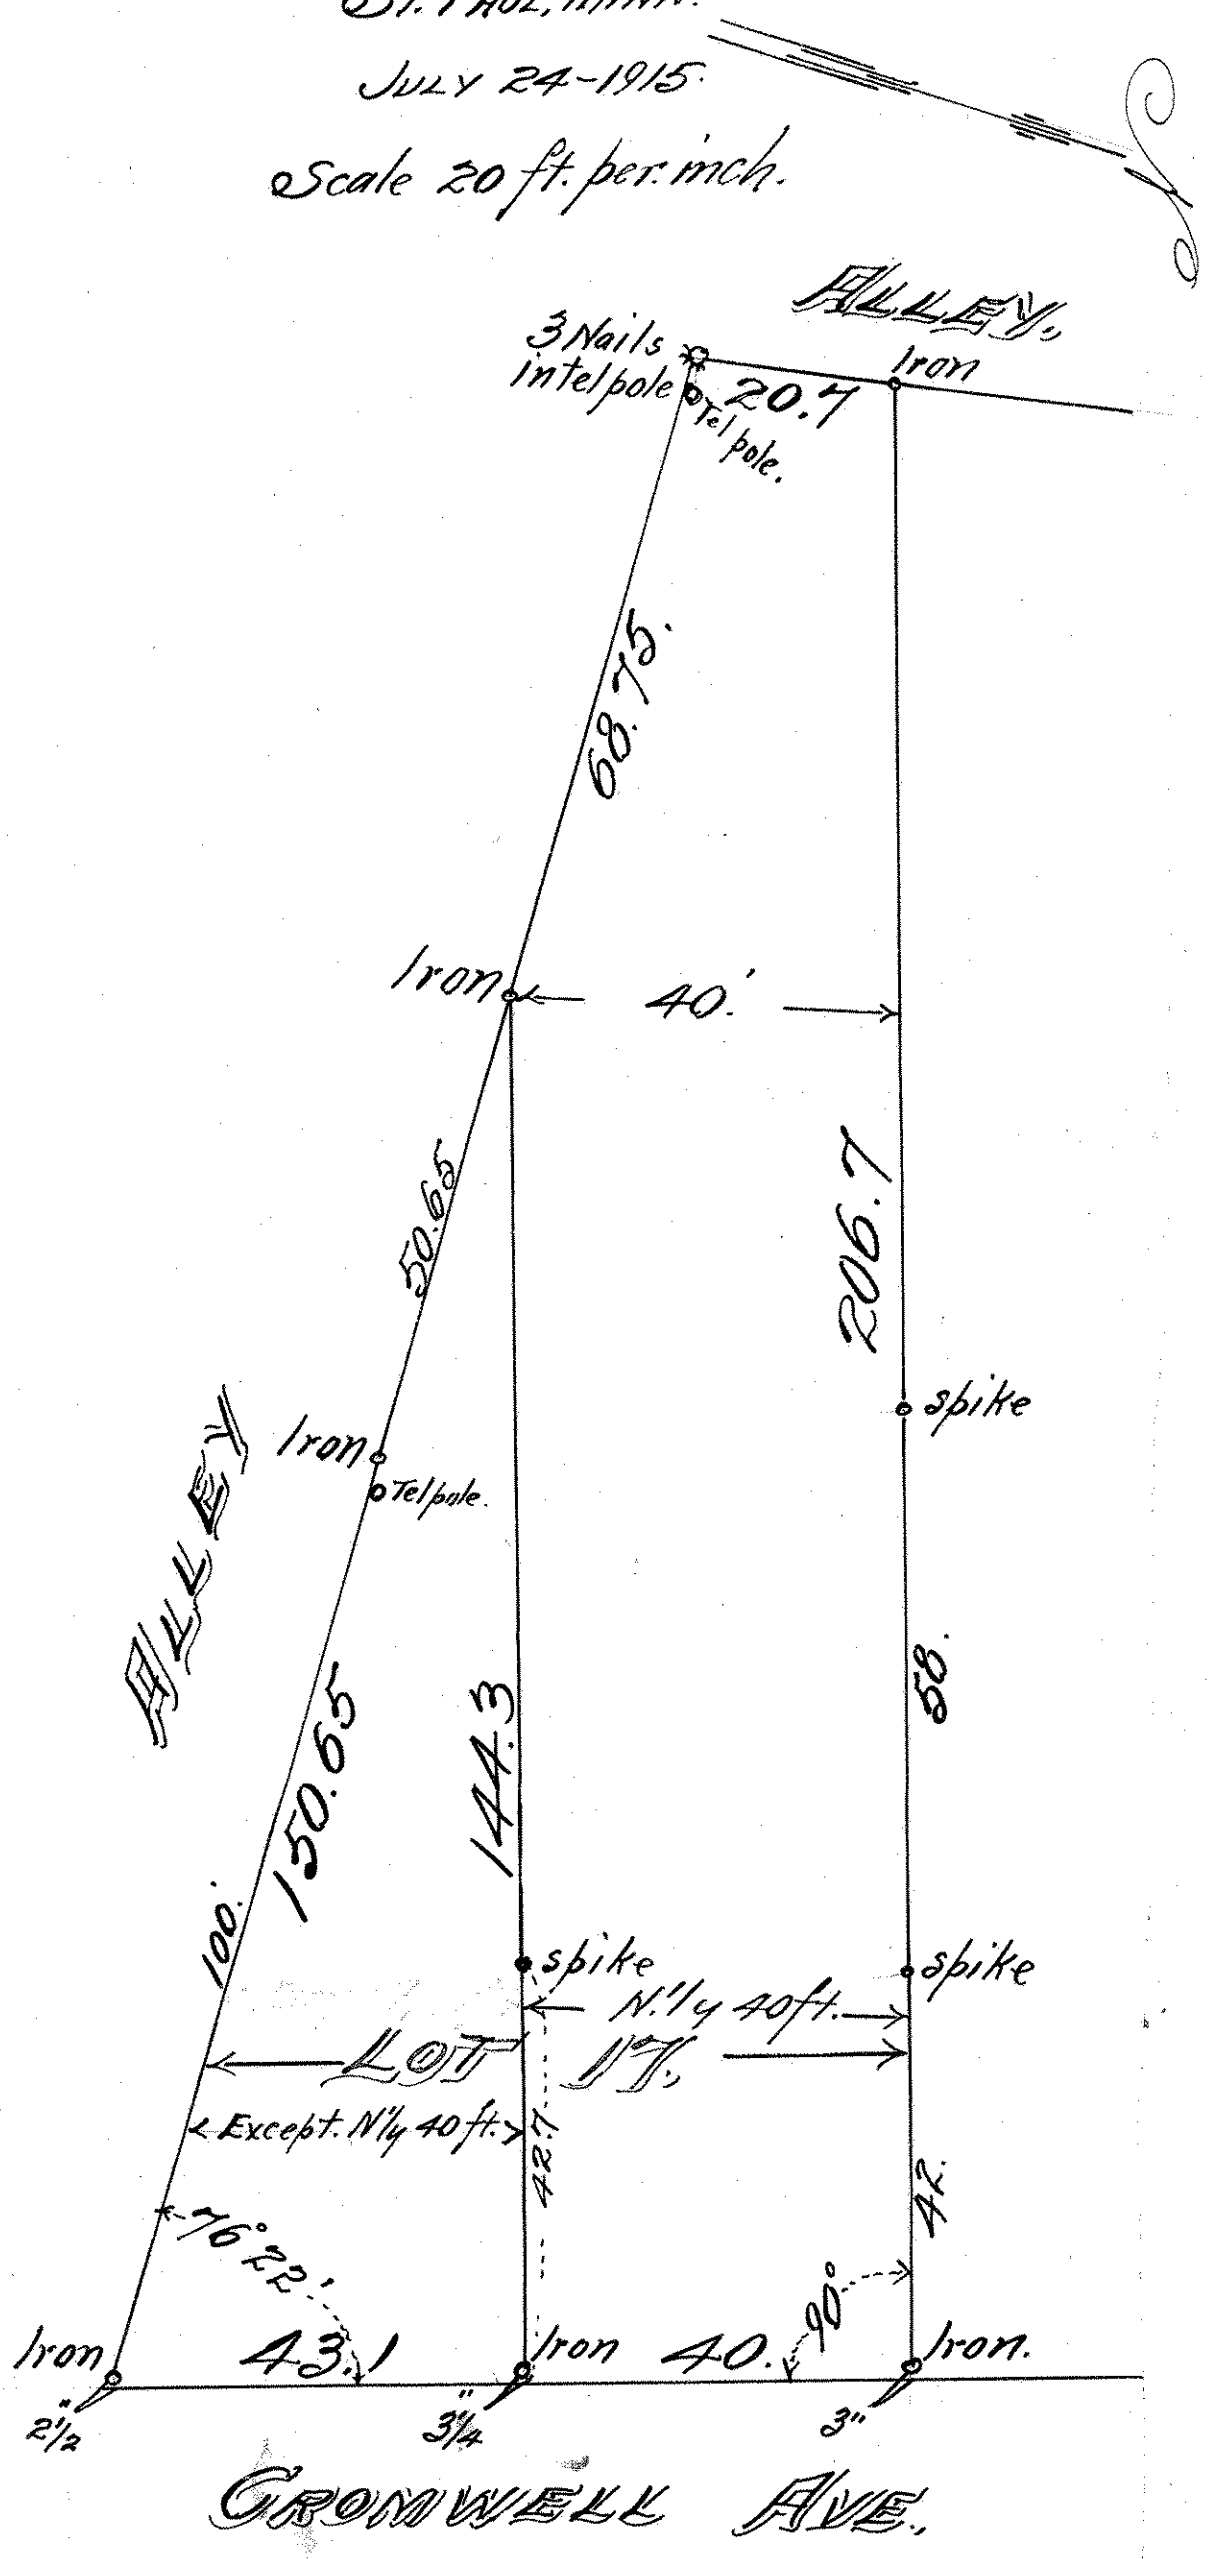
JOHN B. IRVINE SURVEYOR.
408 GLOBE BLDG.
ST. PAUL, MINN.
JULY 24-1915.
Scale 20 ft. per inch.