


LOT 11 BLOCK 80.
ST. ANTHONY
PARK
PLAT NO. 1

JOHN B. IRVINE. SURVEYOR.
416 GLOBE BLDG.
ST PAUL MINN.
SEPT. 21-06.

SCALE 1 IN. = 20 FT.

ALLEY, 20'

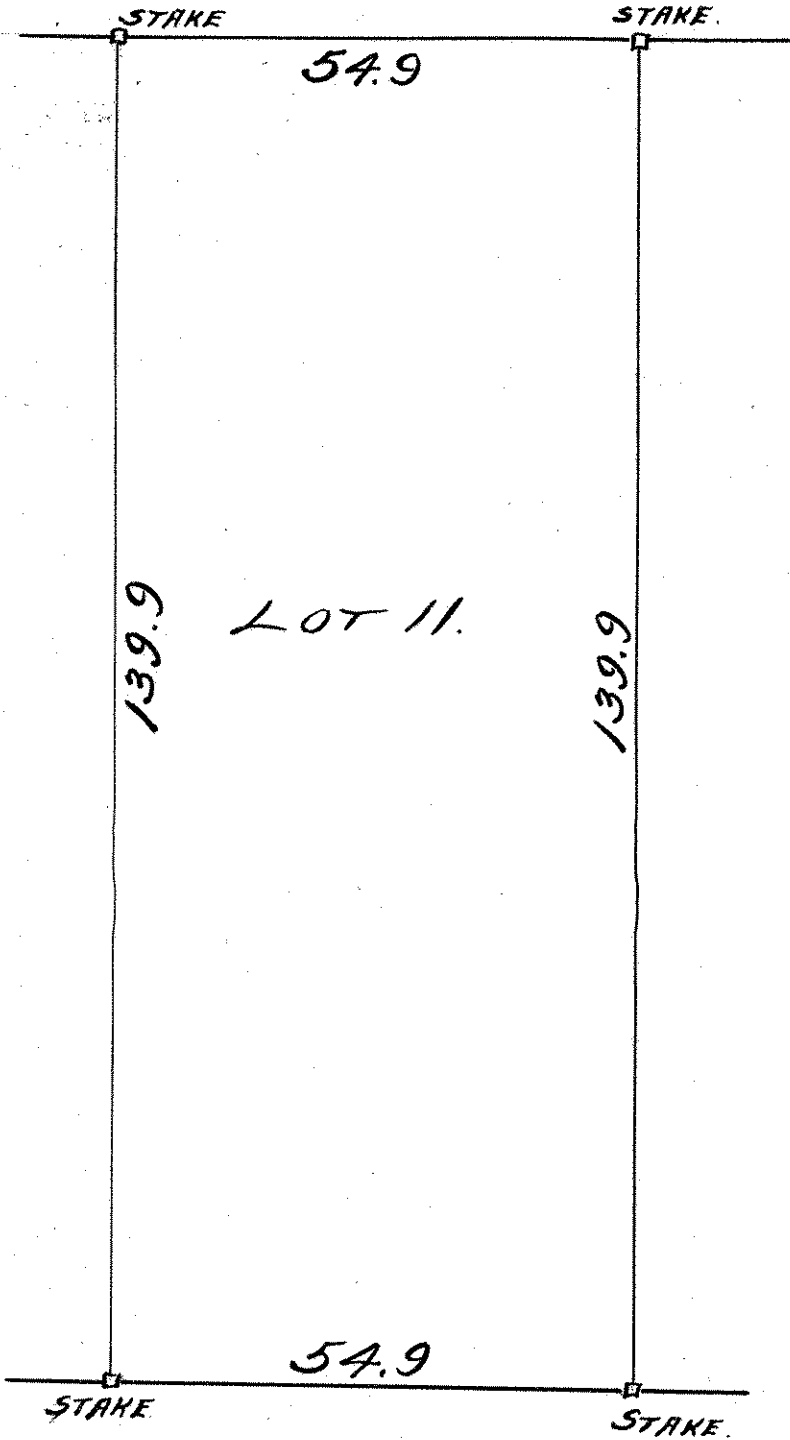

LONG AVE., 60'