


LONG AVE. 60.

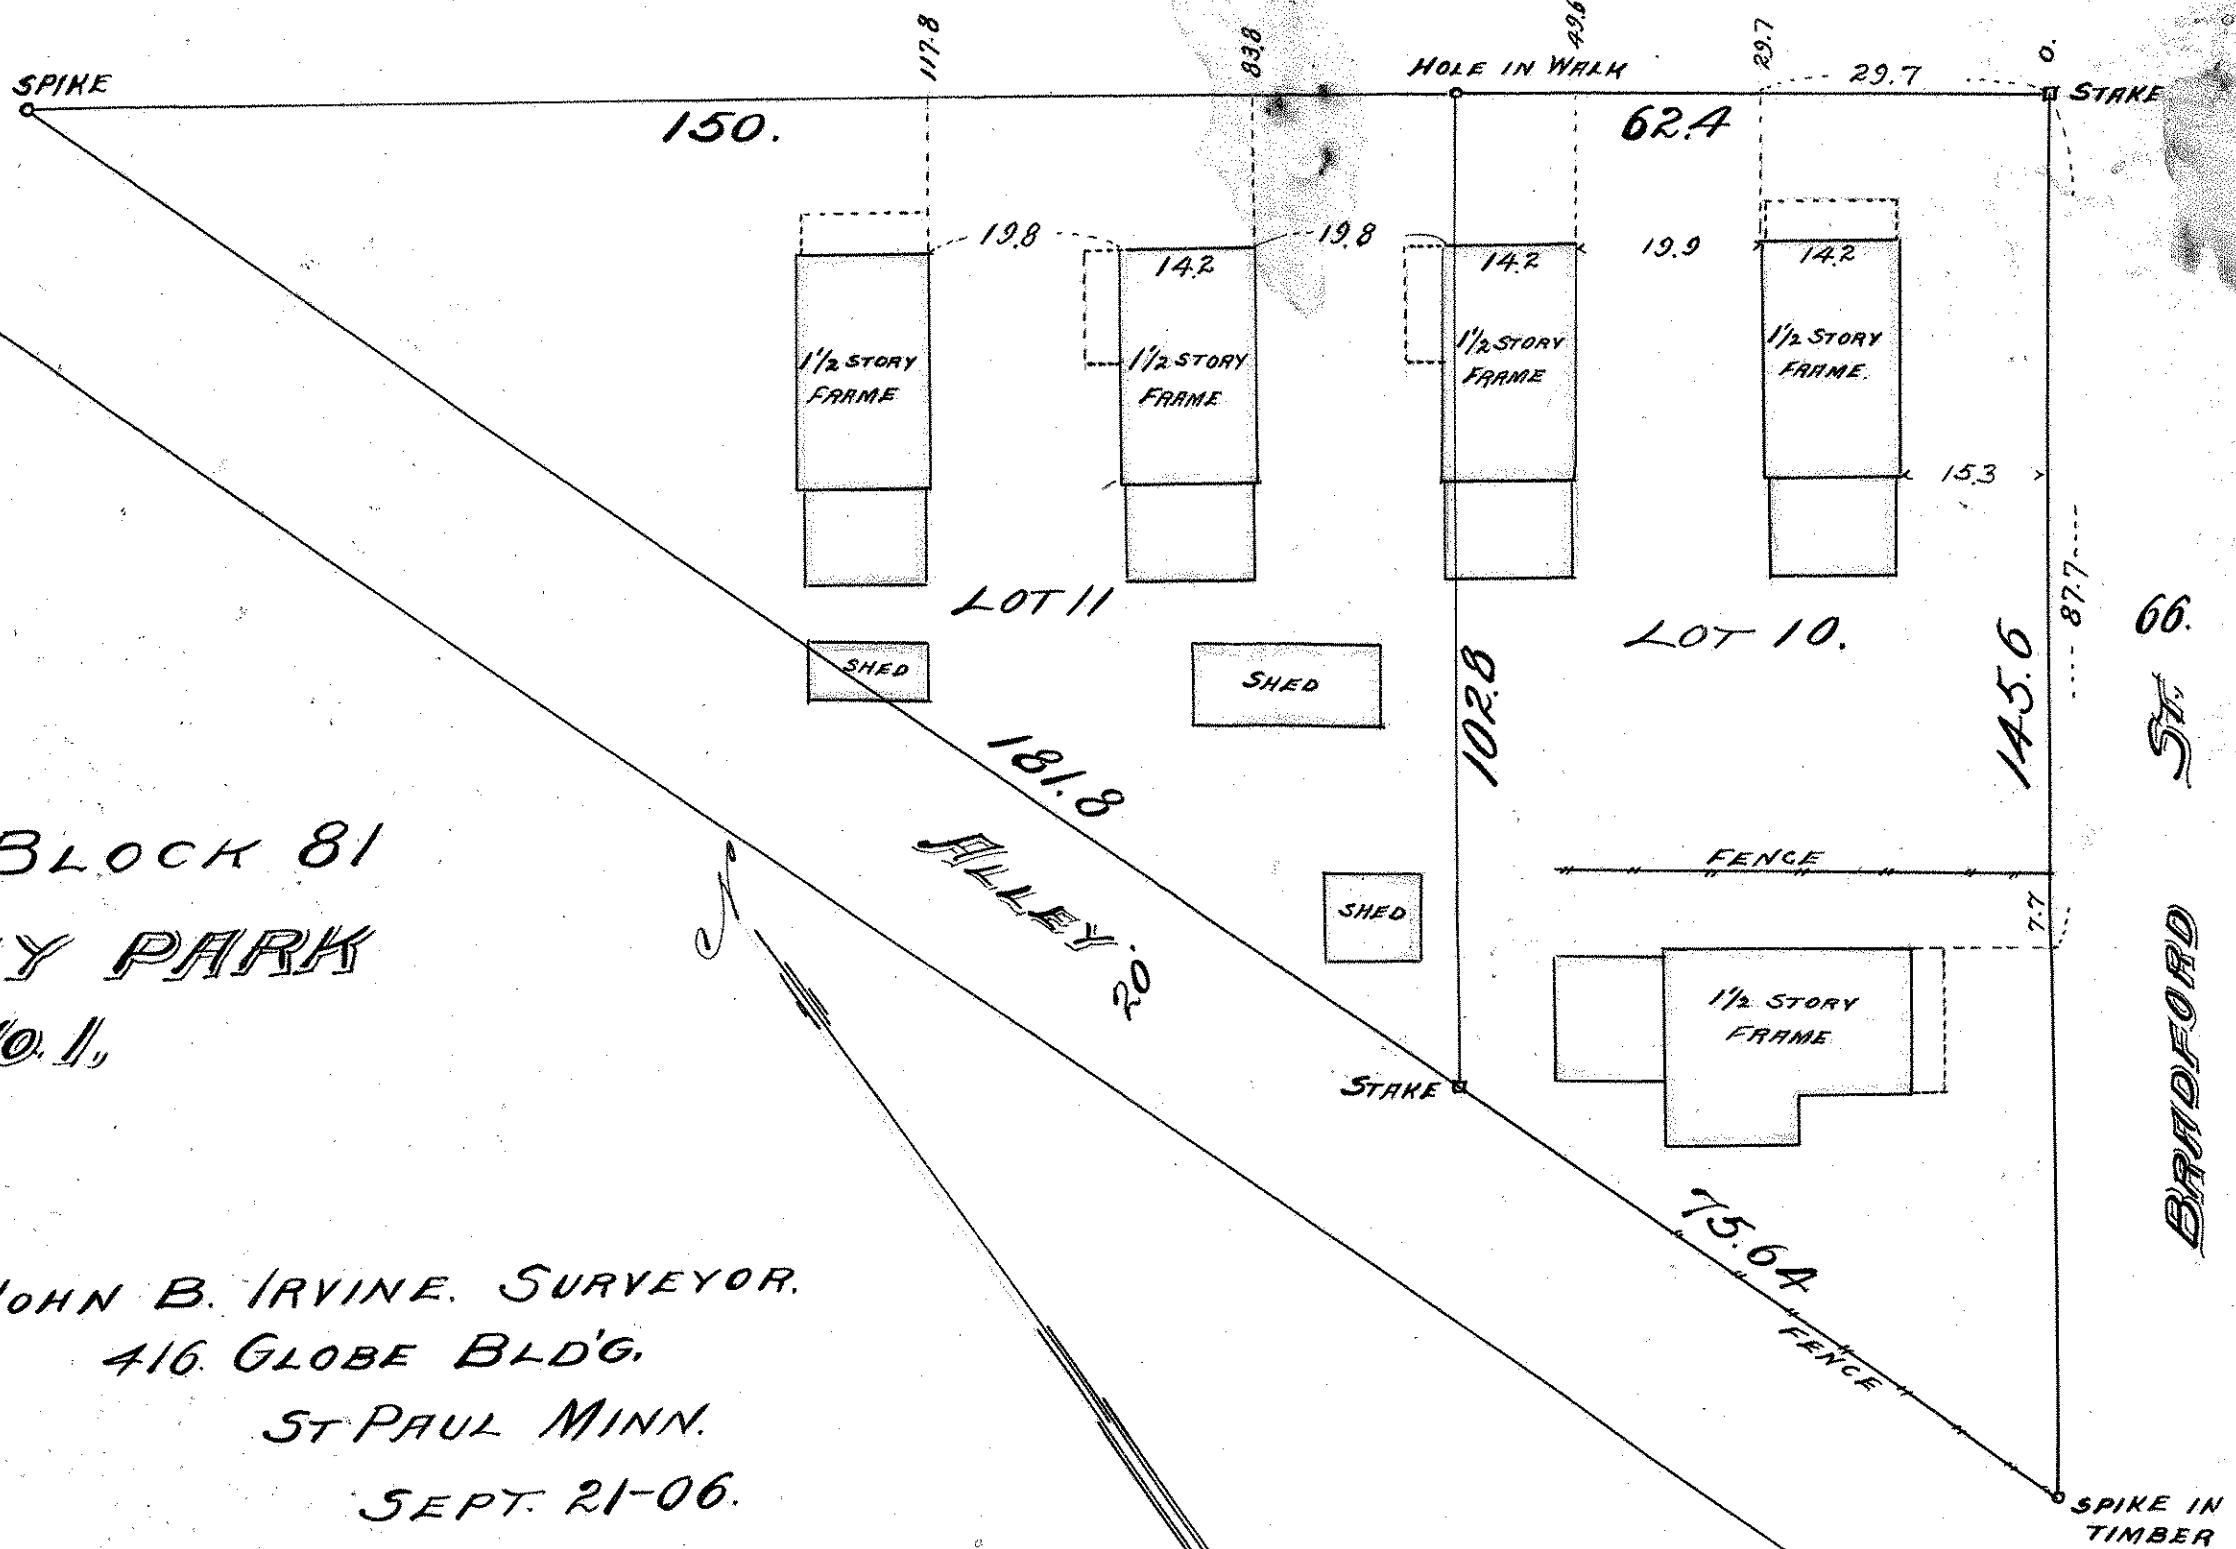

LOTS 10 & 11 BLOCK 81
 ST ANTHONY PARK
 PLAT NO. 1,

JOHN B. IRVINE. SURVEYOR.
 416. GLOBE BLD'G.
 ST PAUL MINN.

SEPT. 21-06.

SCALE 1 IN. = 20 FT.