


BLOCK C. ST. ANTHONY PARK, NORTH.

JOHN B. IRVINE, SURVEYOR.
ST. PAUL MINN.
AUG. 18-1908
SCALE 60 ft per inch.

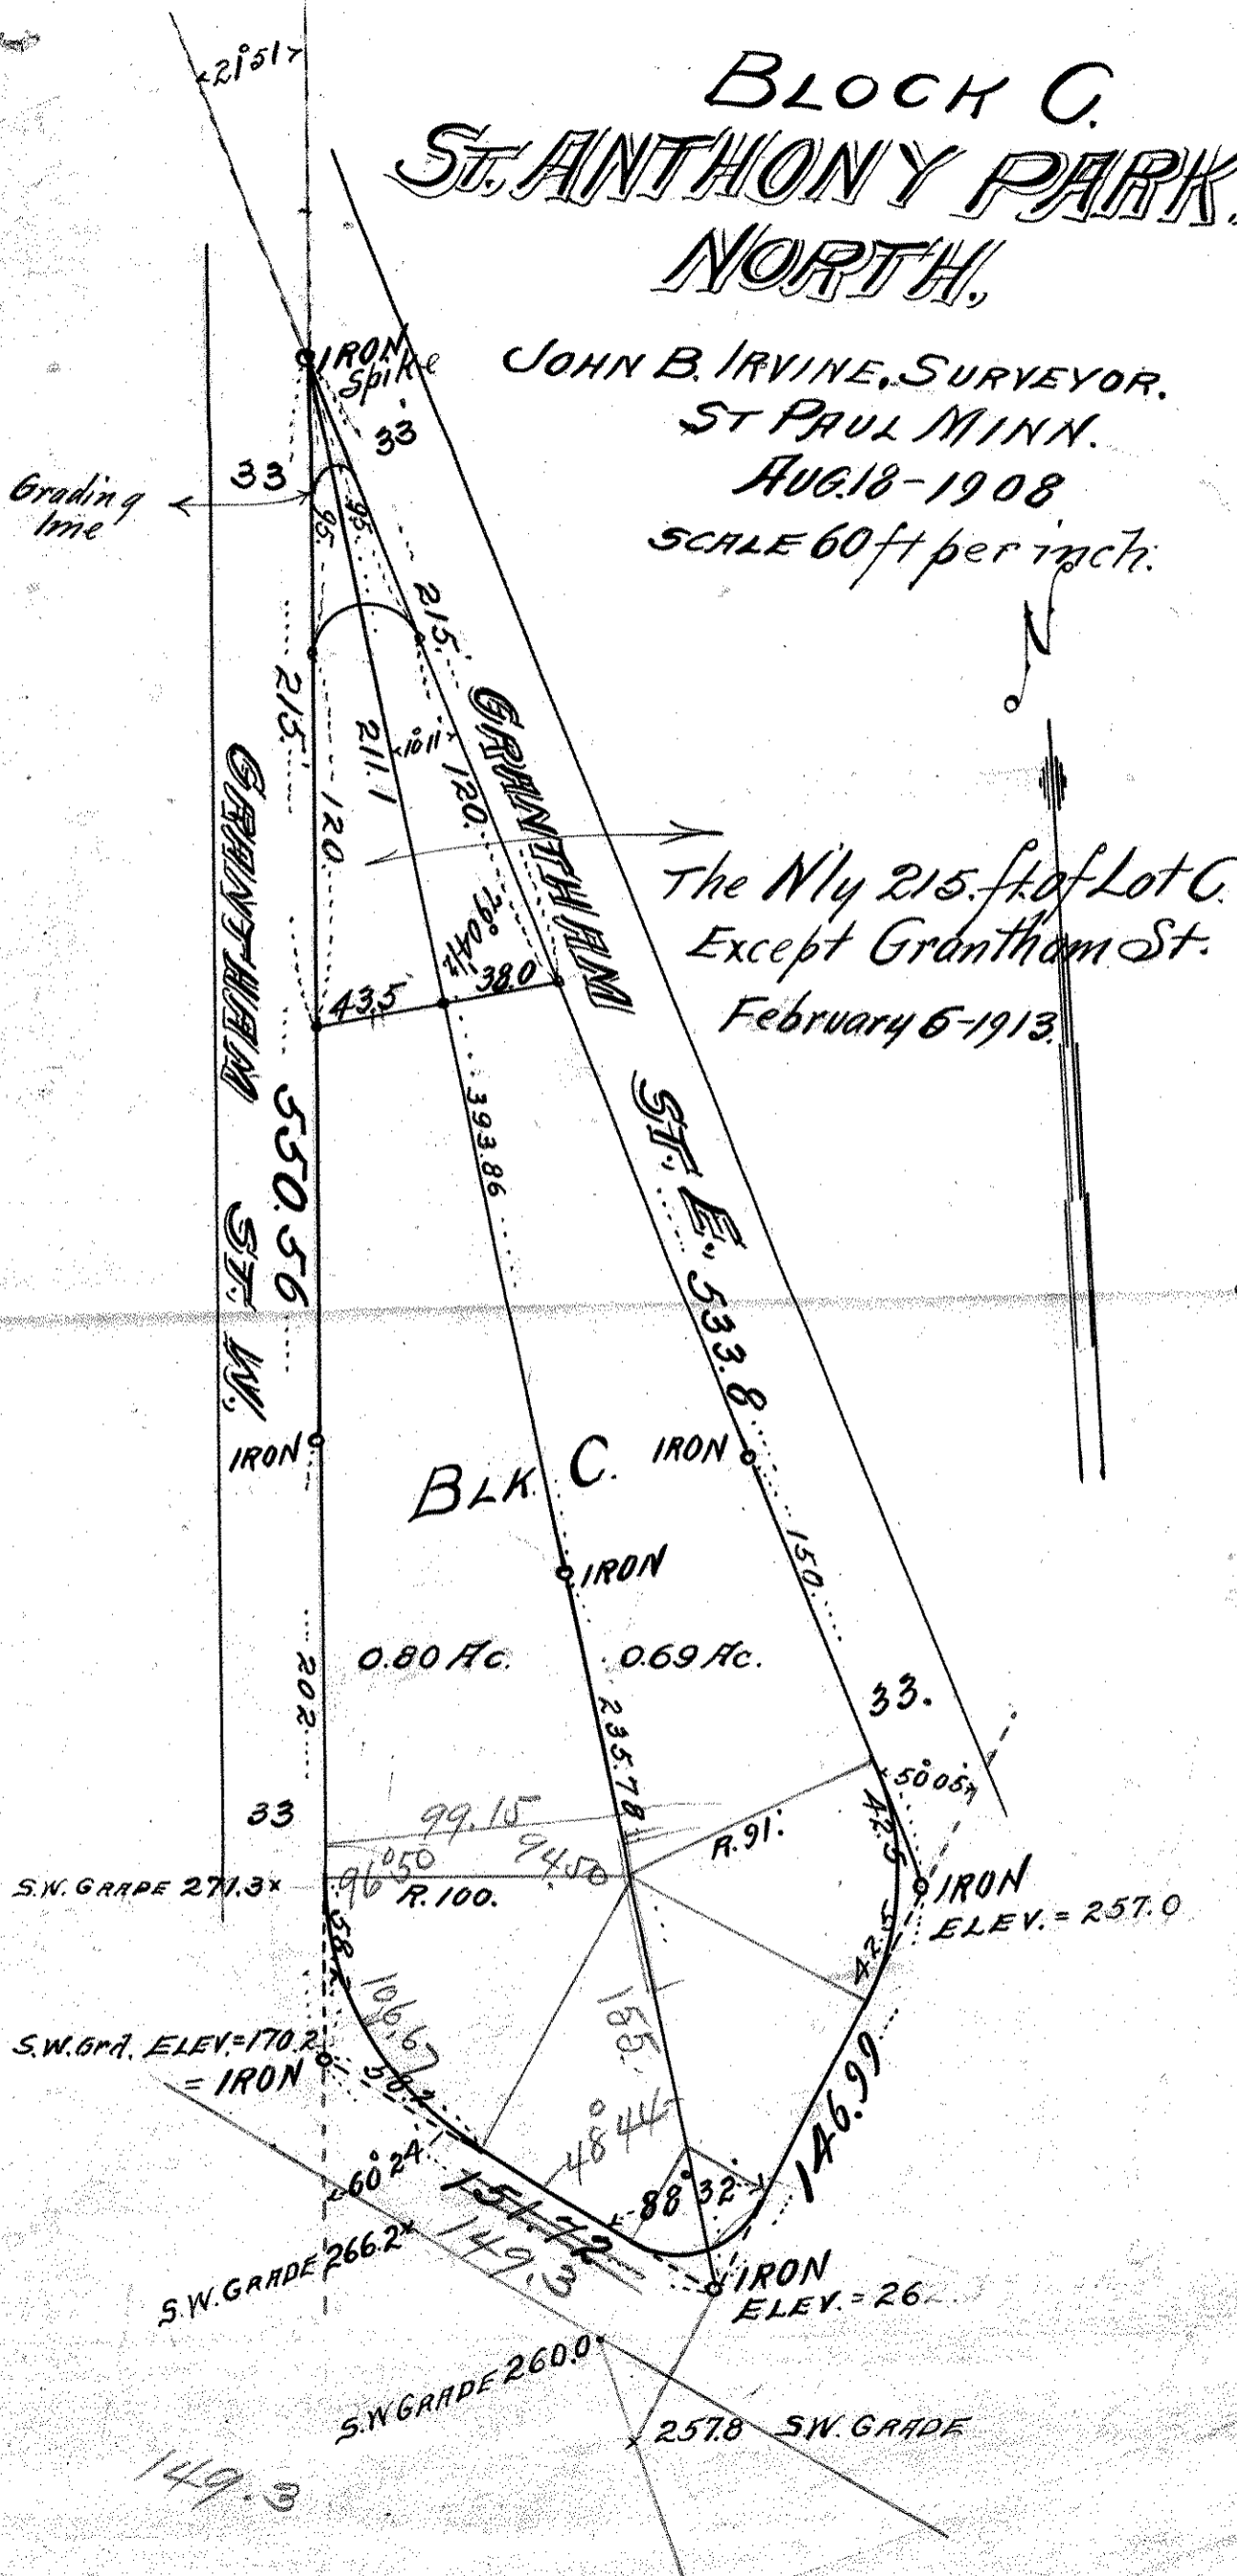

The Nly 215. ft. of Lot C.
Except Grantham St.
February 6-1913.

BLK. C. IRON

0.80 Ac.

0.69 Ac.

S.W. GRADE 271.3*

S.W. GRADE 170.2
= IRON

S.W. GRADE 266.2*

S.W. GRADE 260.0*

257.8 S.W. GRADE

IRON
ELEV. = 257.0

IRON
ELEV. = 26...

Grading
line

GRANTHAM ST.


ST. E. 533.8

ST. W. 550.56

215.17

33

IRON
Spike

33

215

215

211.1

120

120

435

380

393.86

550.56

533.8

150

33

33

202

33


















