

PLAT OF SURVEY

OF PROPERTY OF _____



DESCRIBED AS FOLLOWS Lot 11, Block 4, St. Anthony Park North

SCALE: 1 INCH = 40 FEET

o DENOTES IRON

20' ALLEY

T. J. WELCH, REGISTERED SURVEYOR
701 EAST 3RD STREET, ST. PAUL, MINN. 55106

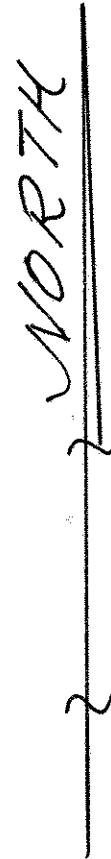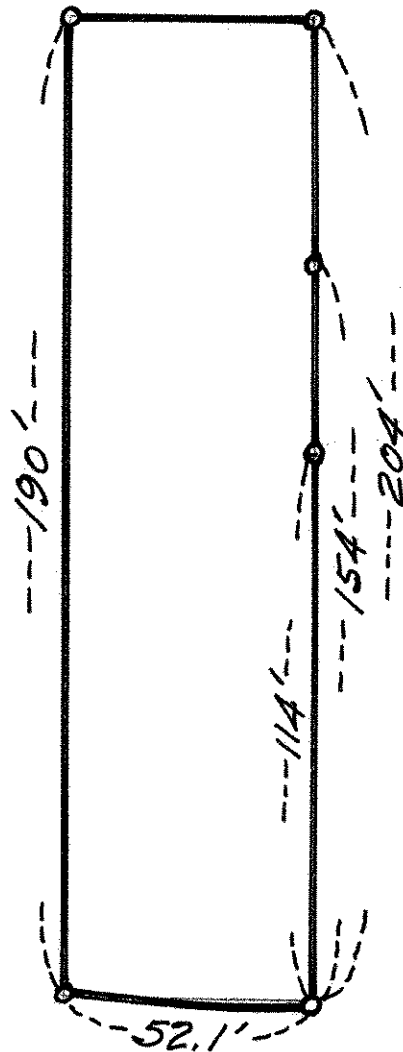

HENDON AVE.

CERTIFICATE OF SURVEY

I hereby certify that on May 16, 1970
I surveyed the property described above and that the above
plat is a correct representation of said survey.

T. J. Welch