


# PLAT OF SURVEY

OF PROPERTY OF \_\_\_\_\_

DESCRIBED AS FOLLOWS *The Easterly 35 feet of Lot 7 & the Westerly 20 feet of Lot 8, Block 9, St Anthony Park North*

SCALE: 1 INCH 30 FEET  
O Indicates Iron.

T. J. WELCH, REGISTERED SURVEYOR  
738 SURREY AVENUE, ST. PAUL 6, MINN.

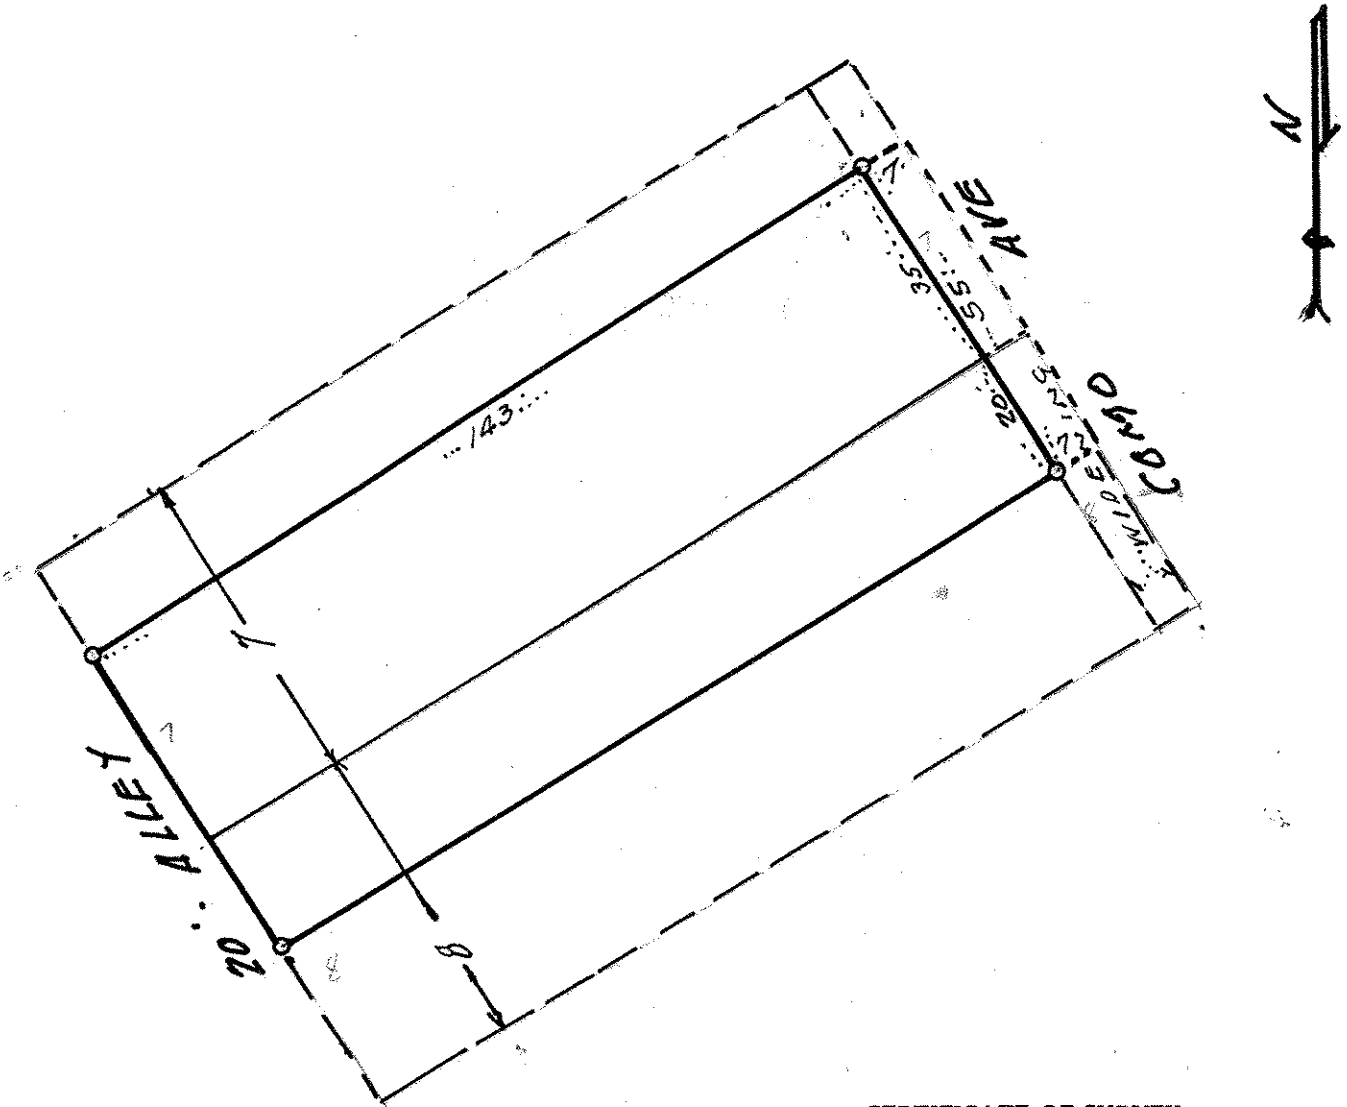

### CERTIFICATE OF SURVEY

I hereby certify that on 11-1 19 52

I surveyed the property described above and that the above plat is a correct representation of said survey.

*T. J. Welch*