

# PLAT OF SURVEY


OF PROPERTY OF \_\_\_\_\_

DESCRIBED AS FOLLOWS Lot 21, Block 9, St. Anthony Park North.

No. 2353 Buford Ave. St. Paul, Minn

SCALE: 1 INCH 30 FEET

T. J. WELCH, REGISTERED SURVEYOR  
738 SURREY AVENUE, ST. PAUL, MINN.

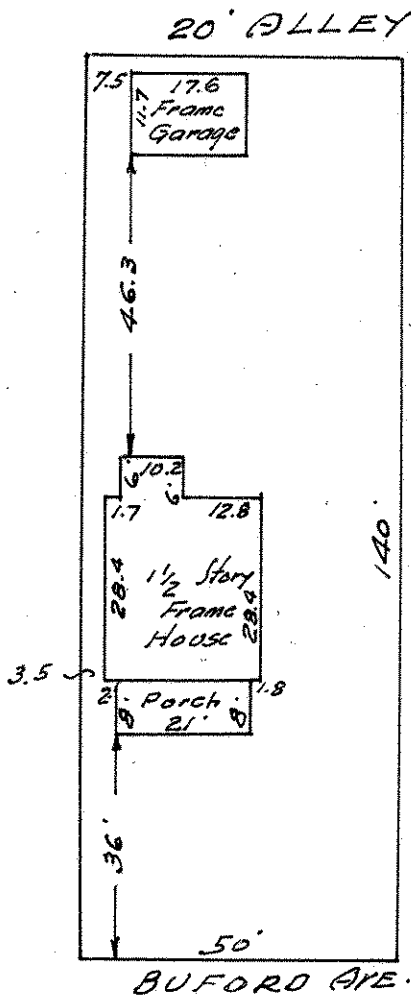

NORTH

### CERTIFICATE OF SURVEY

I hereby certify that on June 8, 1944.

I surveyed the property described above and that the above plat is a correct representation of said survey.

T. J. Welch