

TELEPHONE TOWER 0640


PLAT OF SURVEY

OF PROPERTY OF _____

DESCRIBED AS FOLLOWS *The Easterly 35 feet of Lot 7 & the Westerly 20 feet of Lot 8, Block 9, St Anthony Park North*

SCALE: 1 INCH 30 FEET
O Indicates Iron.

T. J. WELCH, REGISTERED SURVEYOR
738 SURREY AVENUE, ST. PAUL 6, MINN.

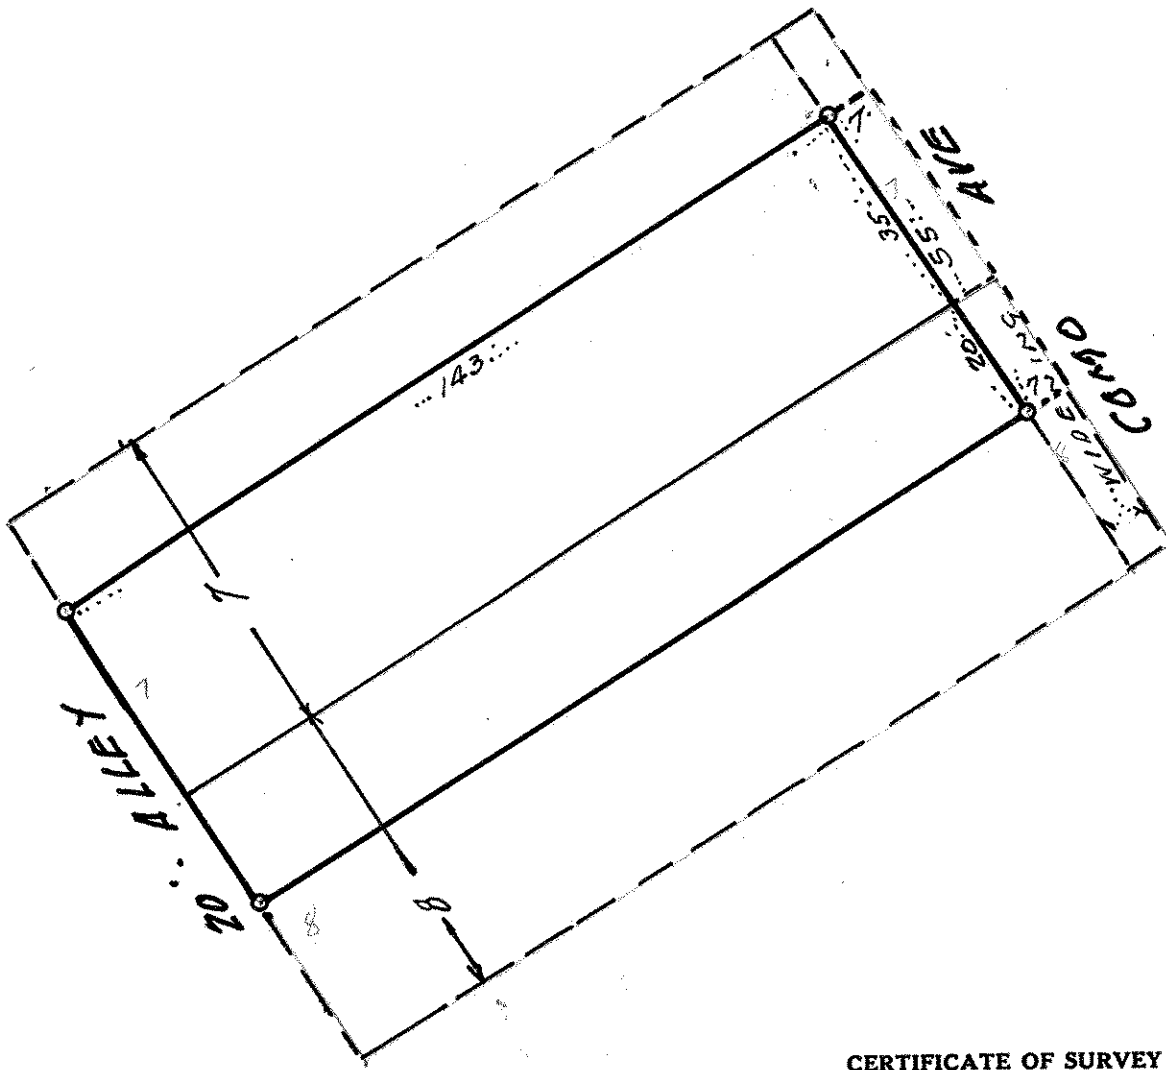

CERTIFICATE OF SURVEY

I hereby certify that on 11-1 1952

I surveyed the property described above and that the above plat is a correct representation of said survey.

T. J. Welch

H