

TELEPHONE TOWER 0640


PLAT OF SURVEY

OF PROPERTY OF _____

DESCRIBED AS FOLLOWS *Lot 21, Block 9, St. Anthony Park North.*
No. 2353 Buford Ave. St. Paul, Minn.

SCALE: 1 INCH *30* FEET

T. J. WELCH, REGISTERED SURVEYOR
738 SURREY AVENUE, ST. PAUL, MINN.

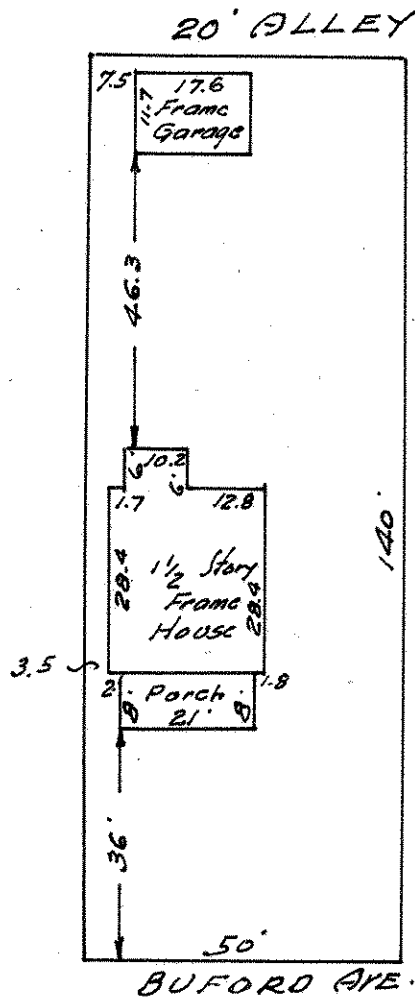

NORTH

CERTIFICATE OF SURVEY

I hereby certify that on June 8, 1944

I surveyed the property described above and that the above plat is a correct representation of said survey.

T. J. Welch