




# PLAT OF SURVEY

Lots 5-6-7-9-11-12 and the South half of Lot 13, Block 16, St. Anthony Park North

SCALE 1 INCH PER 20 FEET

T. J. WELCH  
Registered Surveyor  
738 Surrey Ave.  
ST. PAUL, Minn.

October 22, 1958

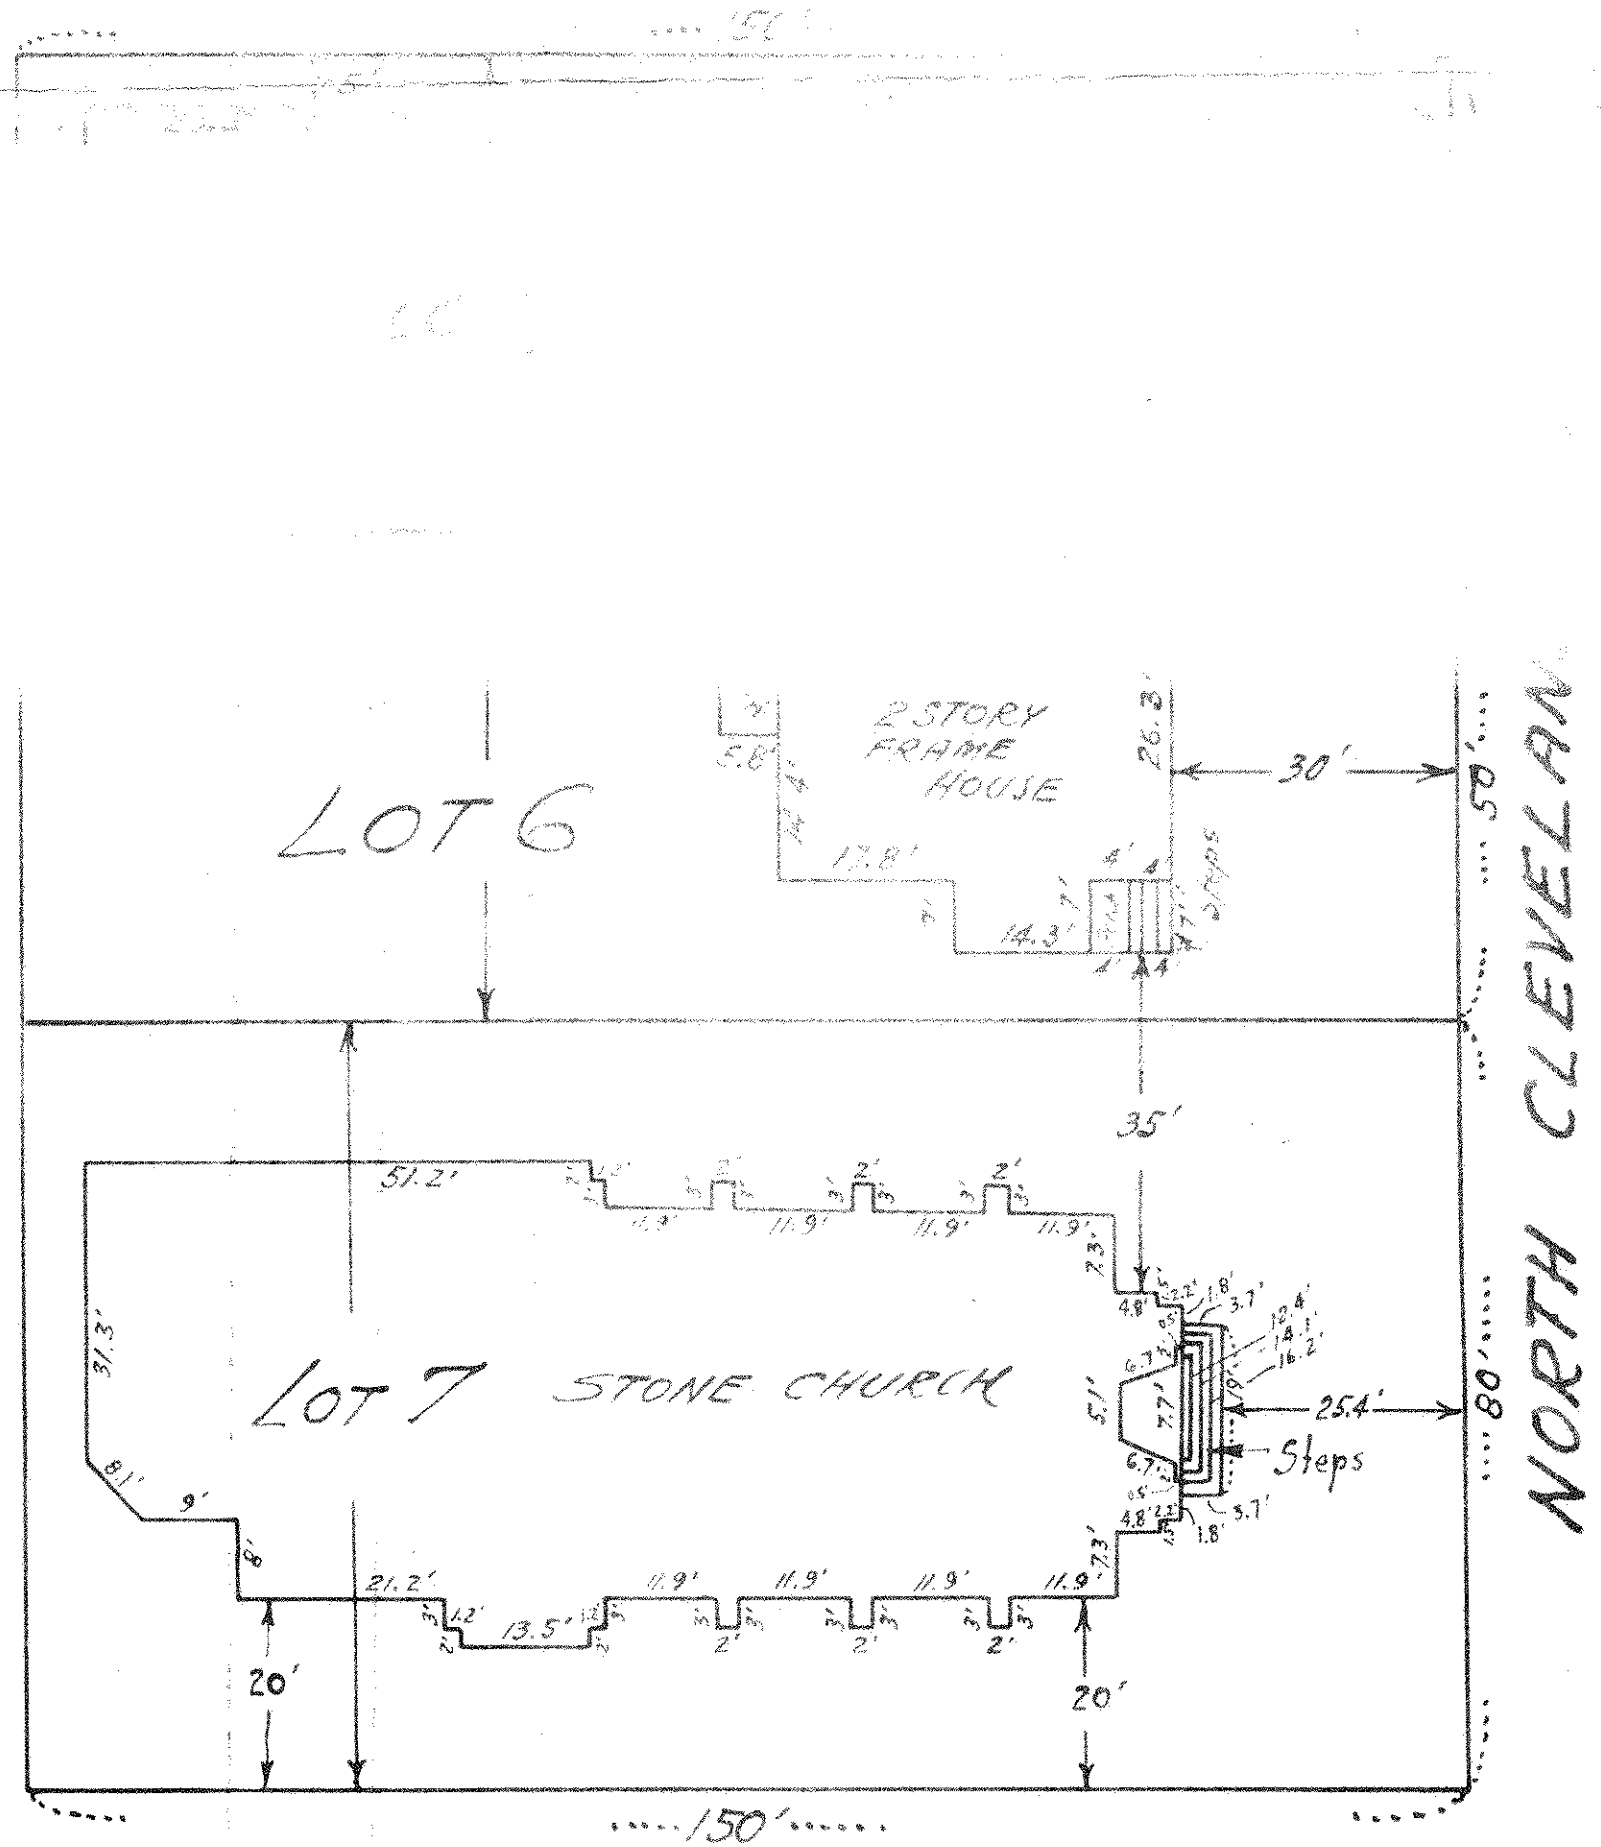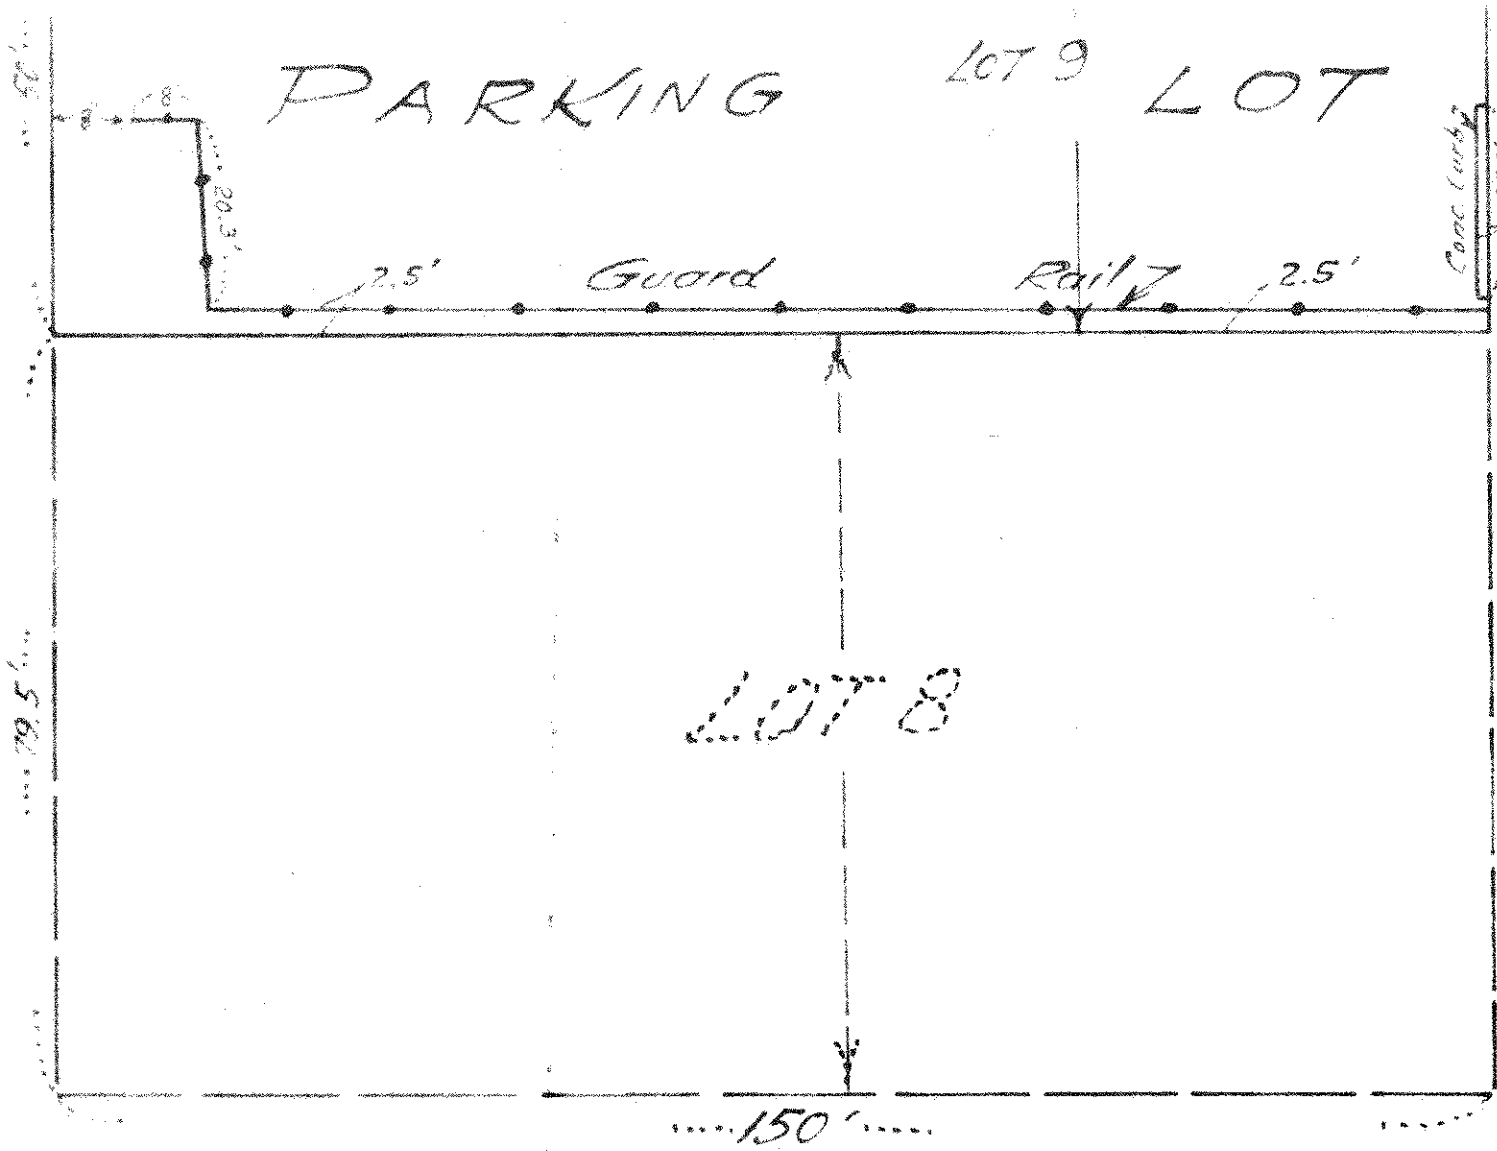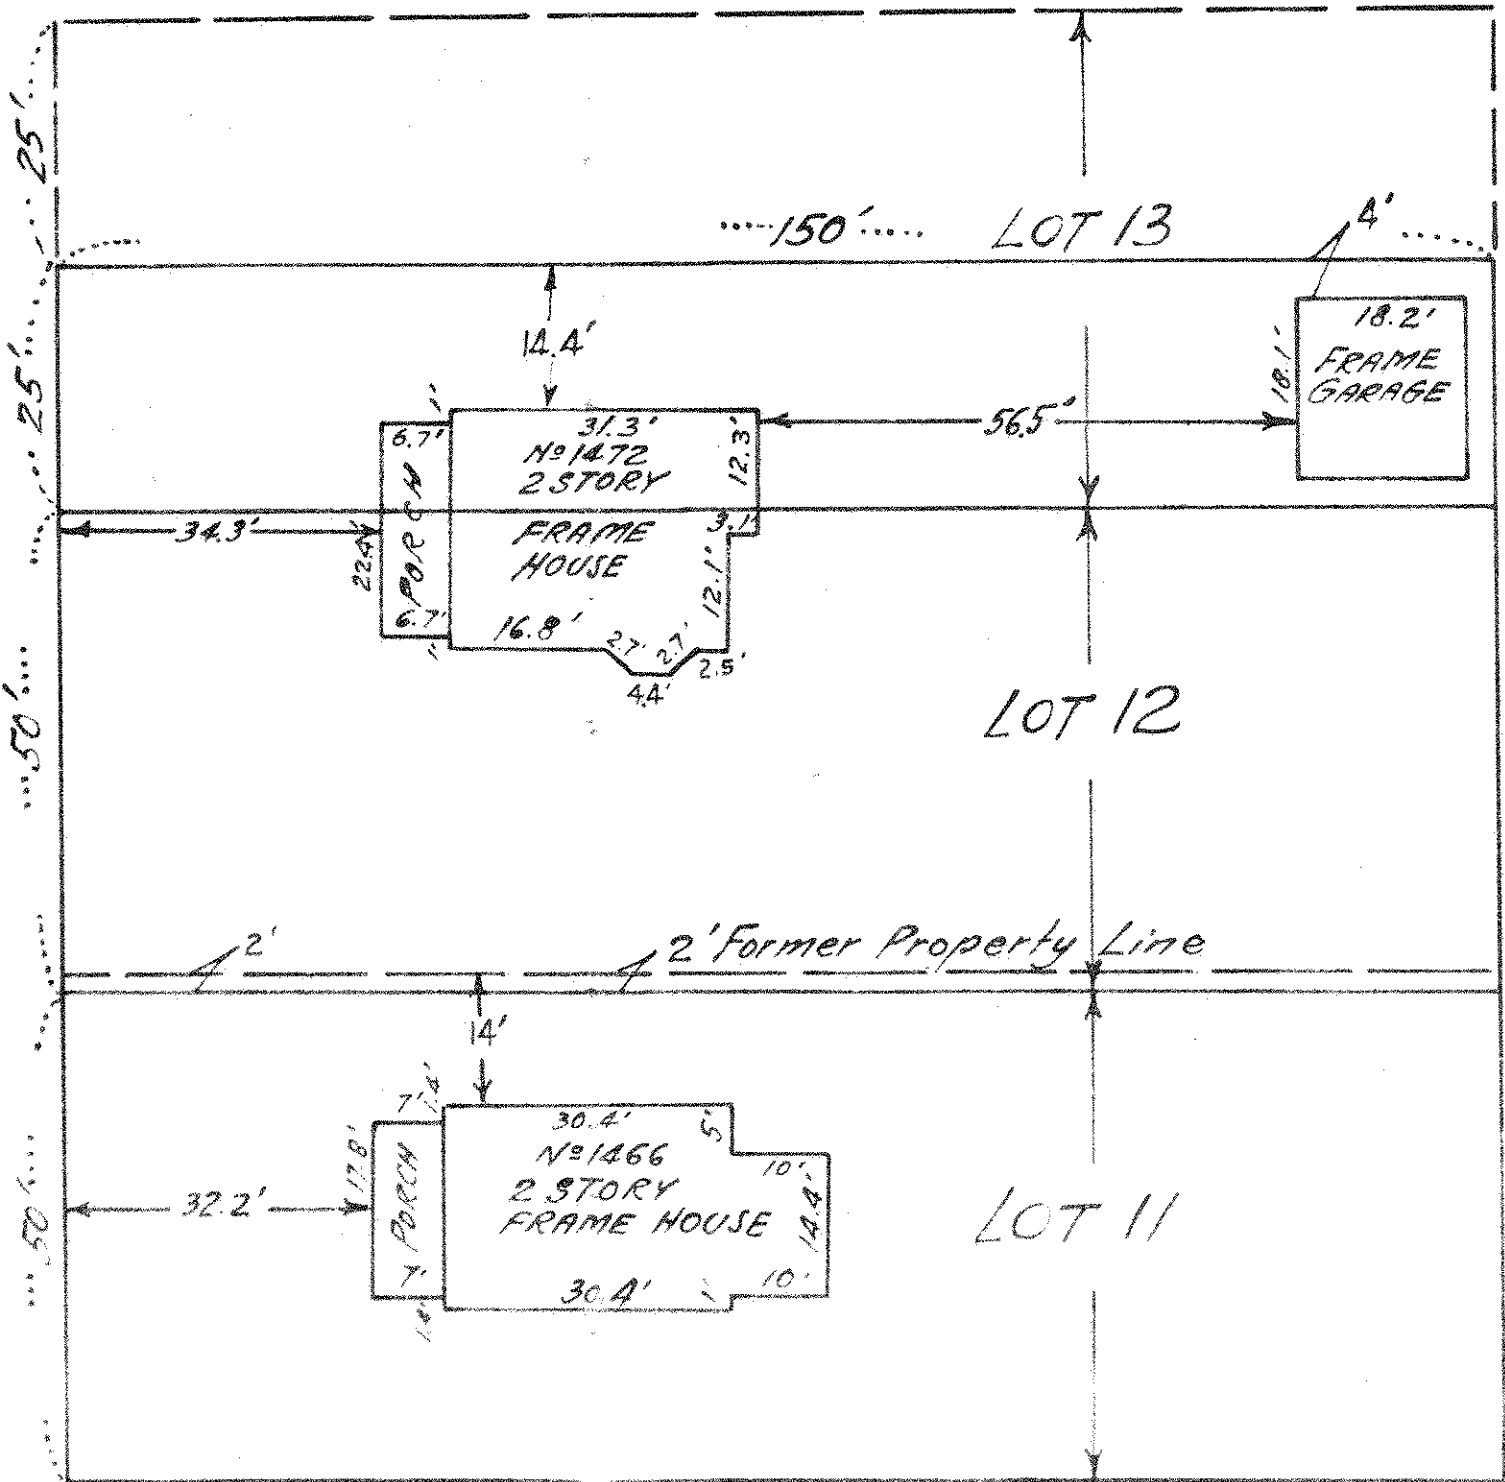

BUFORD

AVENUE