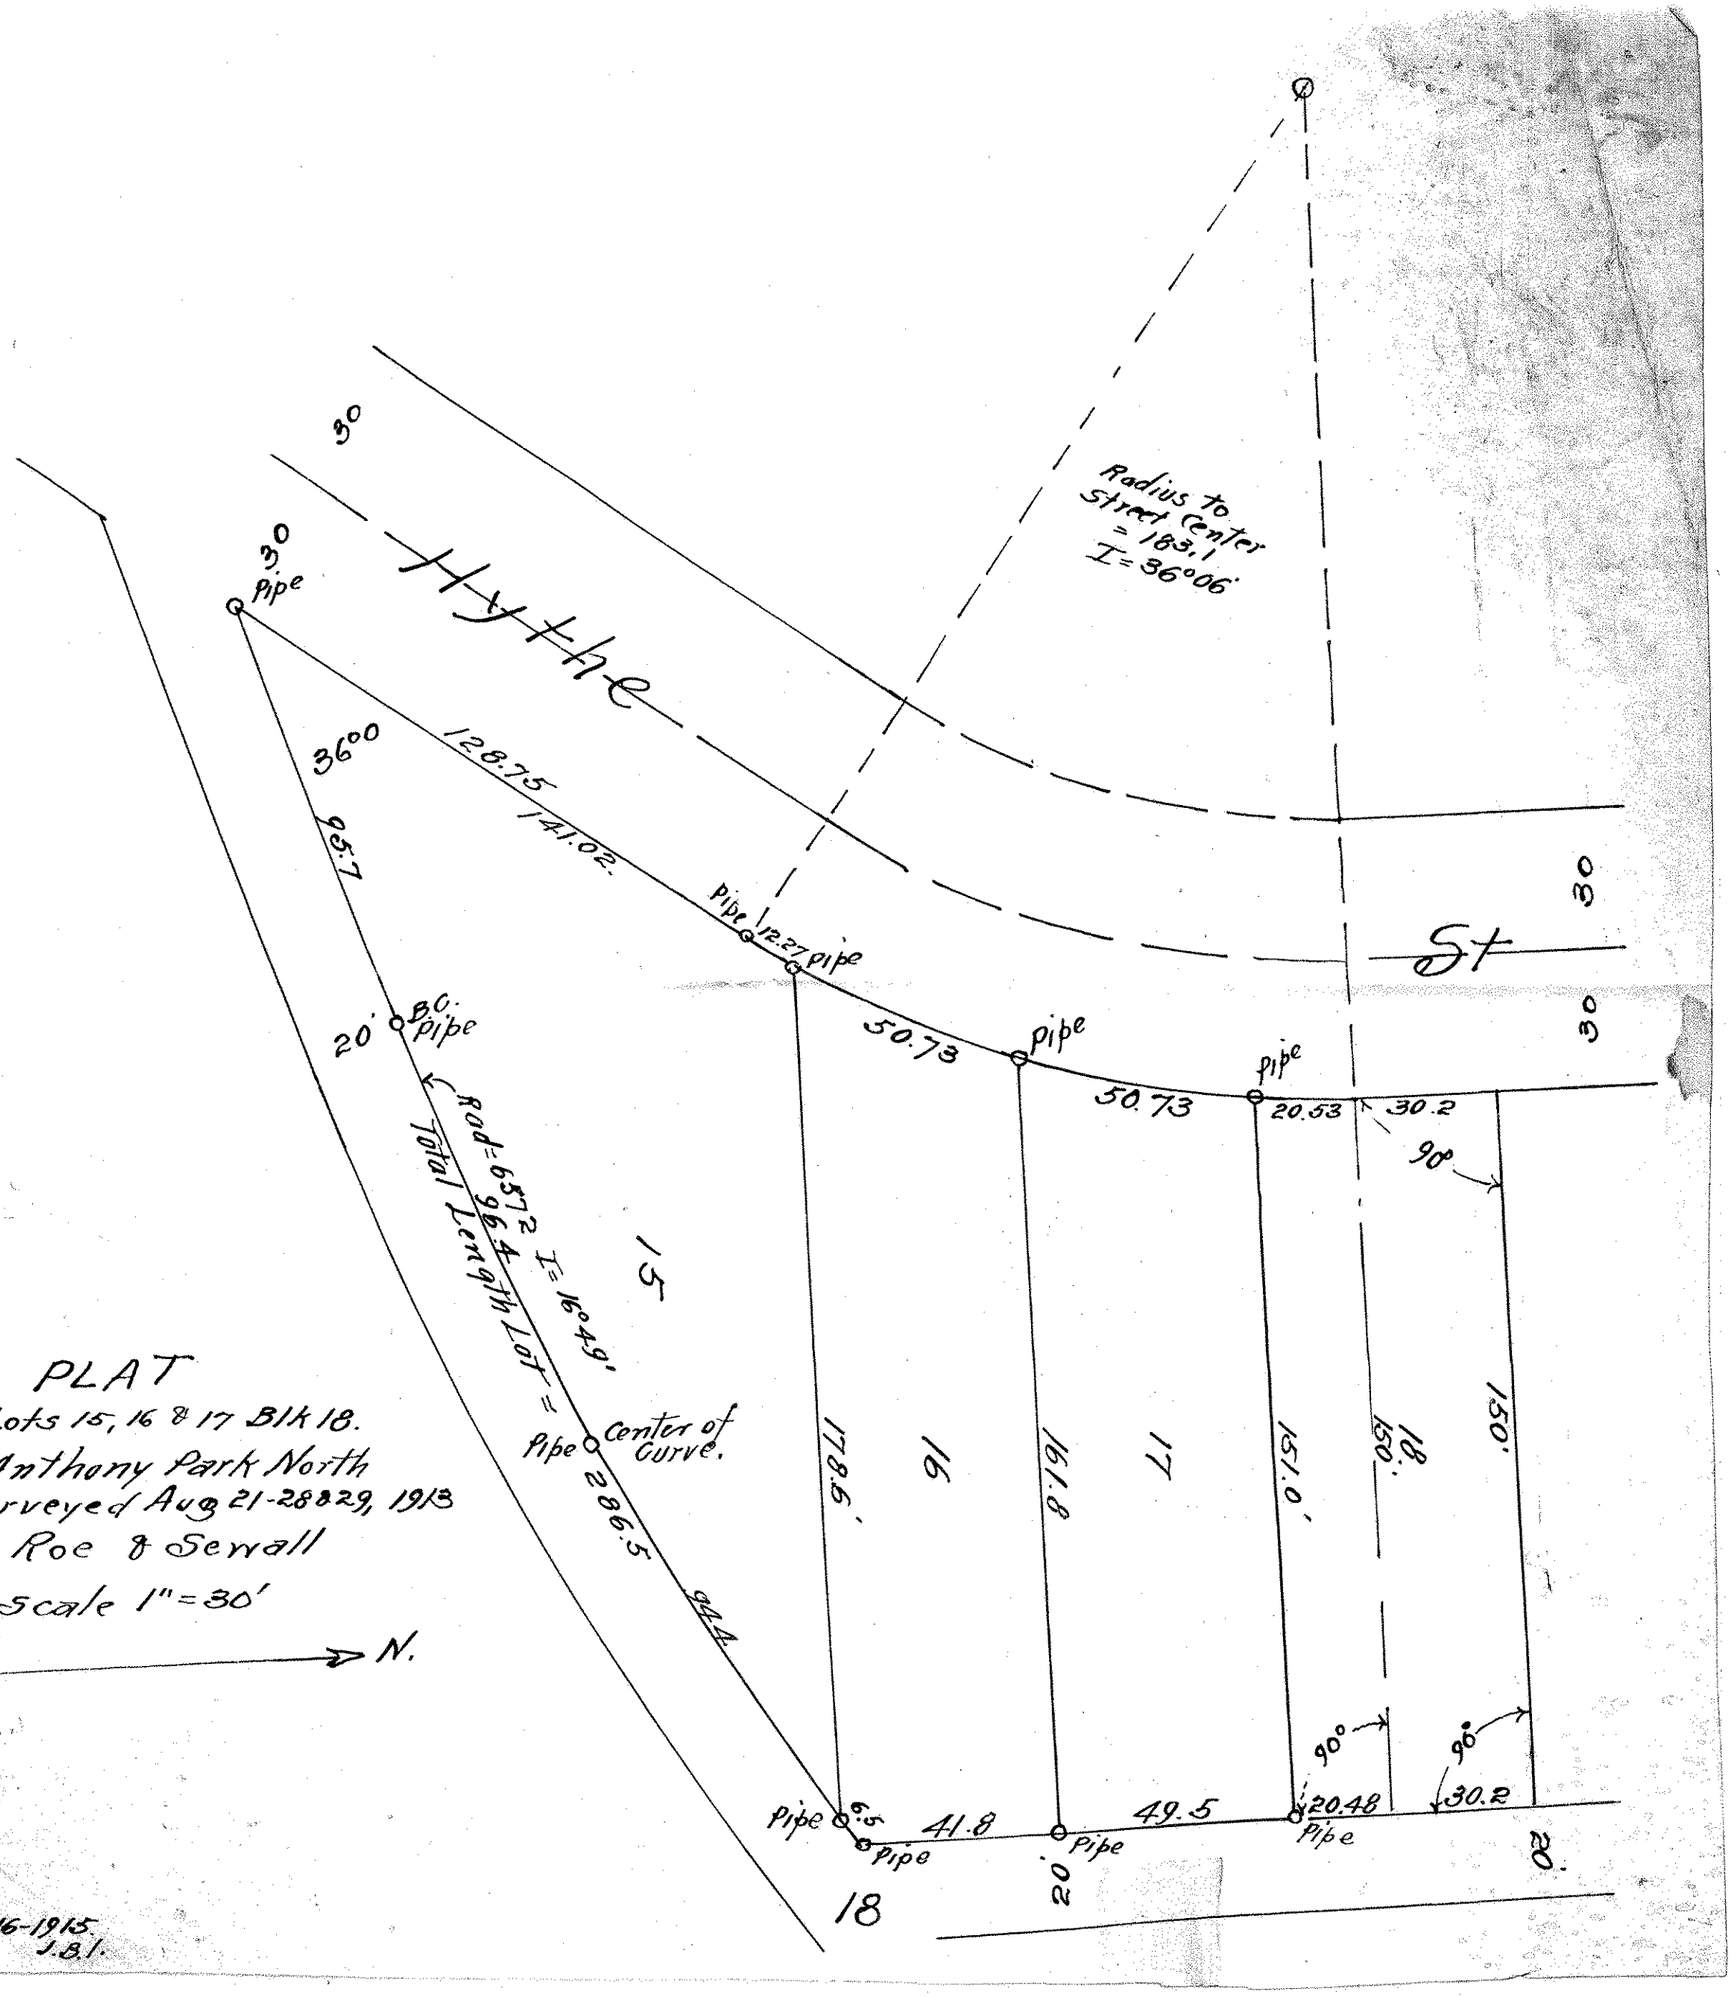

PLAT
of Lots 15, 16 & 17 Blk 18.
St Anthony Park North
as surveyed Aug 21-28&29, 1913
by Roe & Serrall
Scale 1" = 30'

N.

Oct. 16-1915.
J.B.I.