

LOTS 21 & 22 BLOCK 20.

ST. ANTHONY PARK NORTH.


JOHN B. IRVINE, SURVEYOR.

408 GLOBE BLDG.

ST PAUL MINN.

JULY 20-1910.

SCALE 20 ft. per inch.

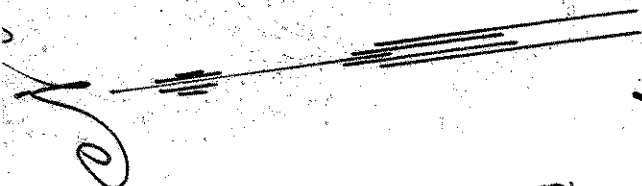

CHELMSFORD

AV.

IRON

IRON.

50.

28.

"Spike"

86.37

86.37

DOUGLASS

spike

170.

155.8

22.

165.0

21

63.63

50.8

87°10'

69.0.

IRON

spike

IRON.

ALLEY 20