

PLAT OF SURVEY

OF PROPERTY OF Rev. William J. Bell.

DESCRIBED AS FOLLOWS Lot 27, Block 20, St. Anthony Park North.


No. 1411 Chelmsford Street, St. Paul, Minn.

T. J. WELCH, REGISTERED SURVEYOR
738 SURREY AVE. ST. PAUL, MINN.

Note, Block 15.7 ft. longer than record.

SCALE: 1 INCH = 30 FEET.

NORTH

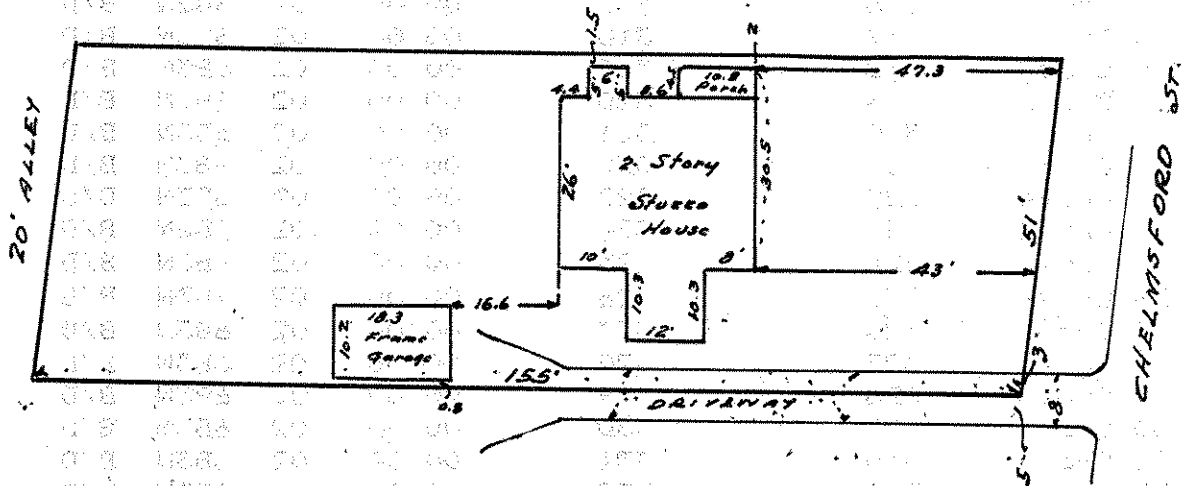

CERTIFICATE OF LOCATION OF BUILDING

I hereby certify that on Dec. 21 1940

I made a survey of the location of the building on the above described property and that the location of said building is correctly shown on the above plat.

T. J. Welch

CERTIFICATE OF SURVEY

I hereby certify that on Dec. 21 1940

I surveyed the property described above and that the above plat is a correct representation of said survey.

T. J. Welch