Appl. 32494

TELEPHONE PR 6-0[illegible]

PLAT OF SURVEY

OF PROPERTY OF Walter E. Englund & Albert Vincent Schroder

DESCRIBED AS FOLLOWS Lot 21, Block 21, St. Anthony Park North

№ 1377 Grantham St., St. Paul, Minn.

SCALE: 1 INCH = 40 FEET

T. J. WELCH, REGISTERED SURVEYOR
738 SURREY AVENUE, ST. PAUL 6, MINN.

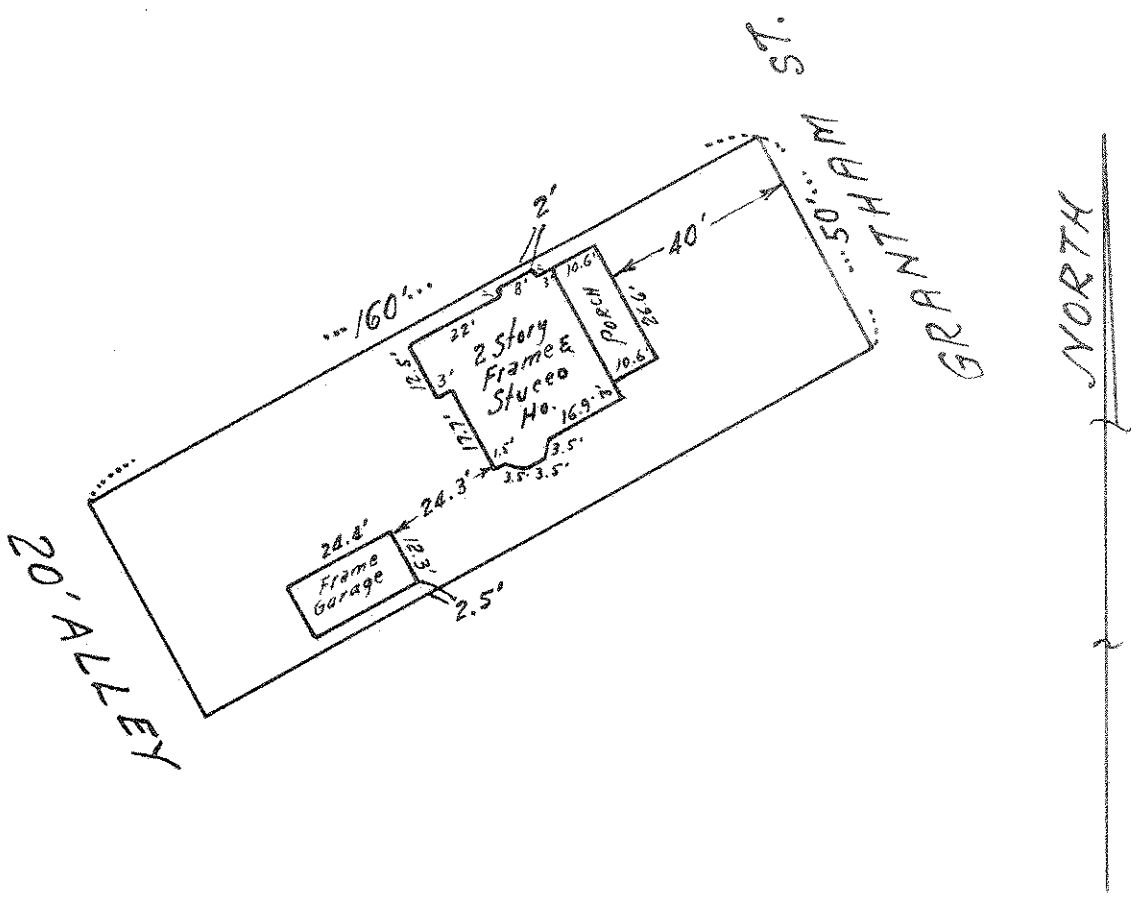

CERTIFICATE OF SURVEY

I hereby certify that on 10-19, 19 60 I surveyed the property described above and that the above plat is a correct representation of said survey.

T. J. Welch