LOTS 1&2 BLOCK 21.

STANTHONY PARK NORTH.

JOHN B. IRVINE, SURVEYOR.
408 GLOBE BLDG.
ST PAUL, MINN.

JUNE 27-1911
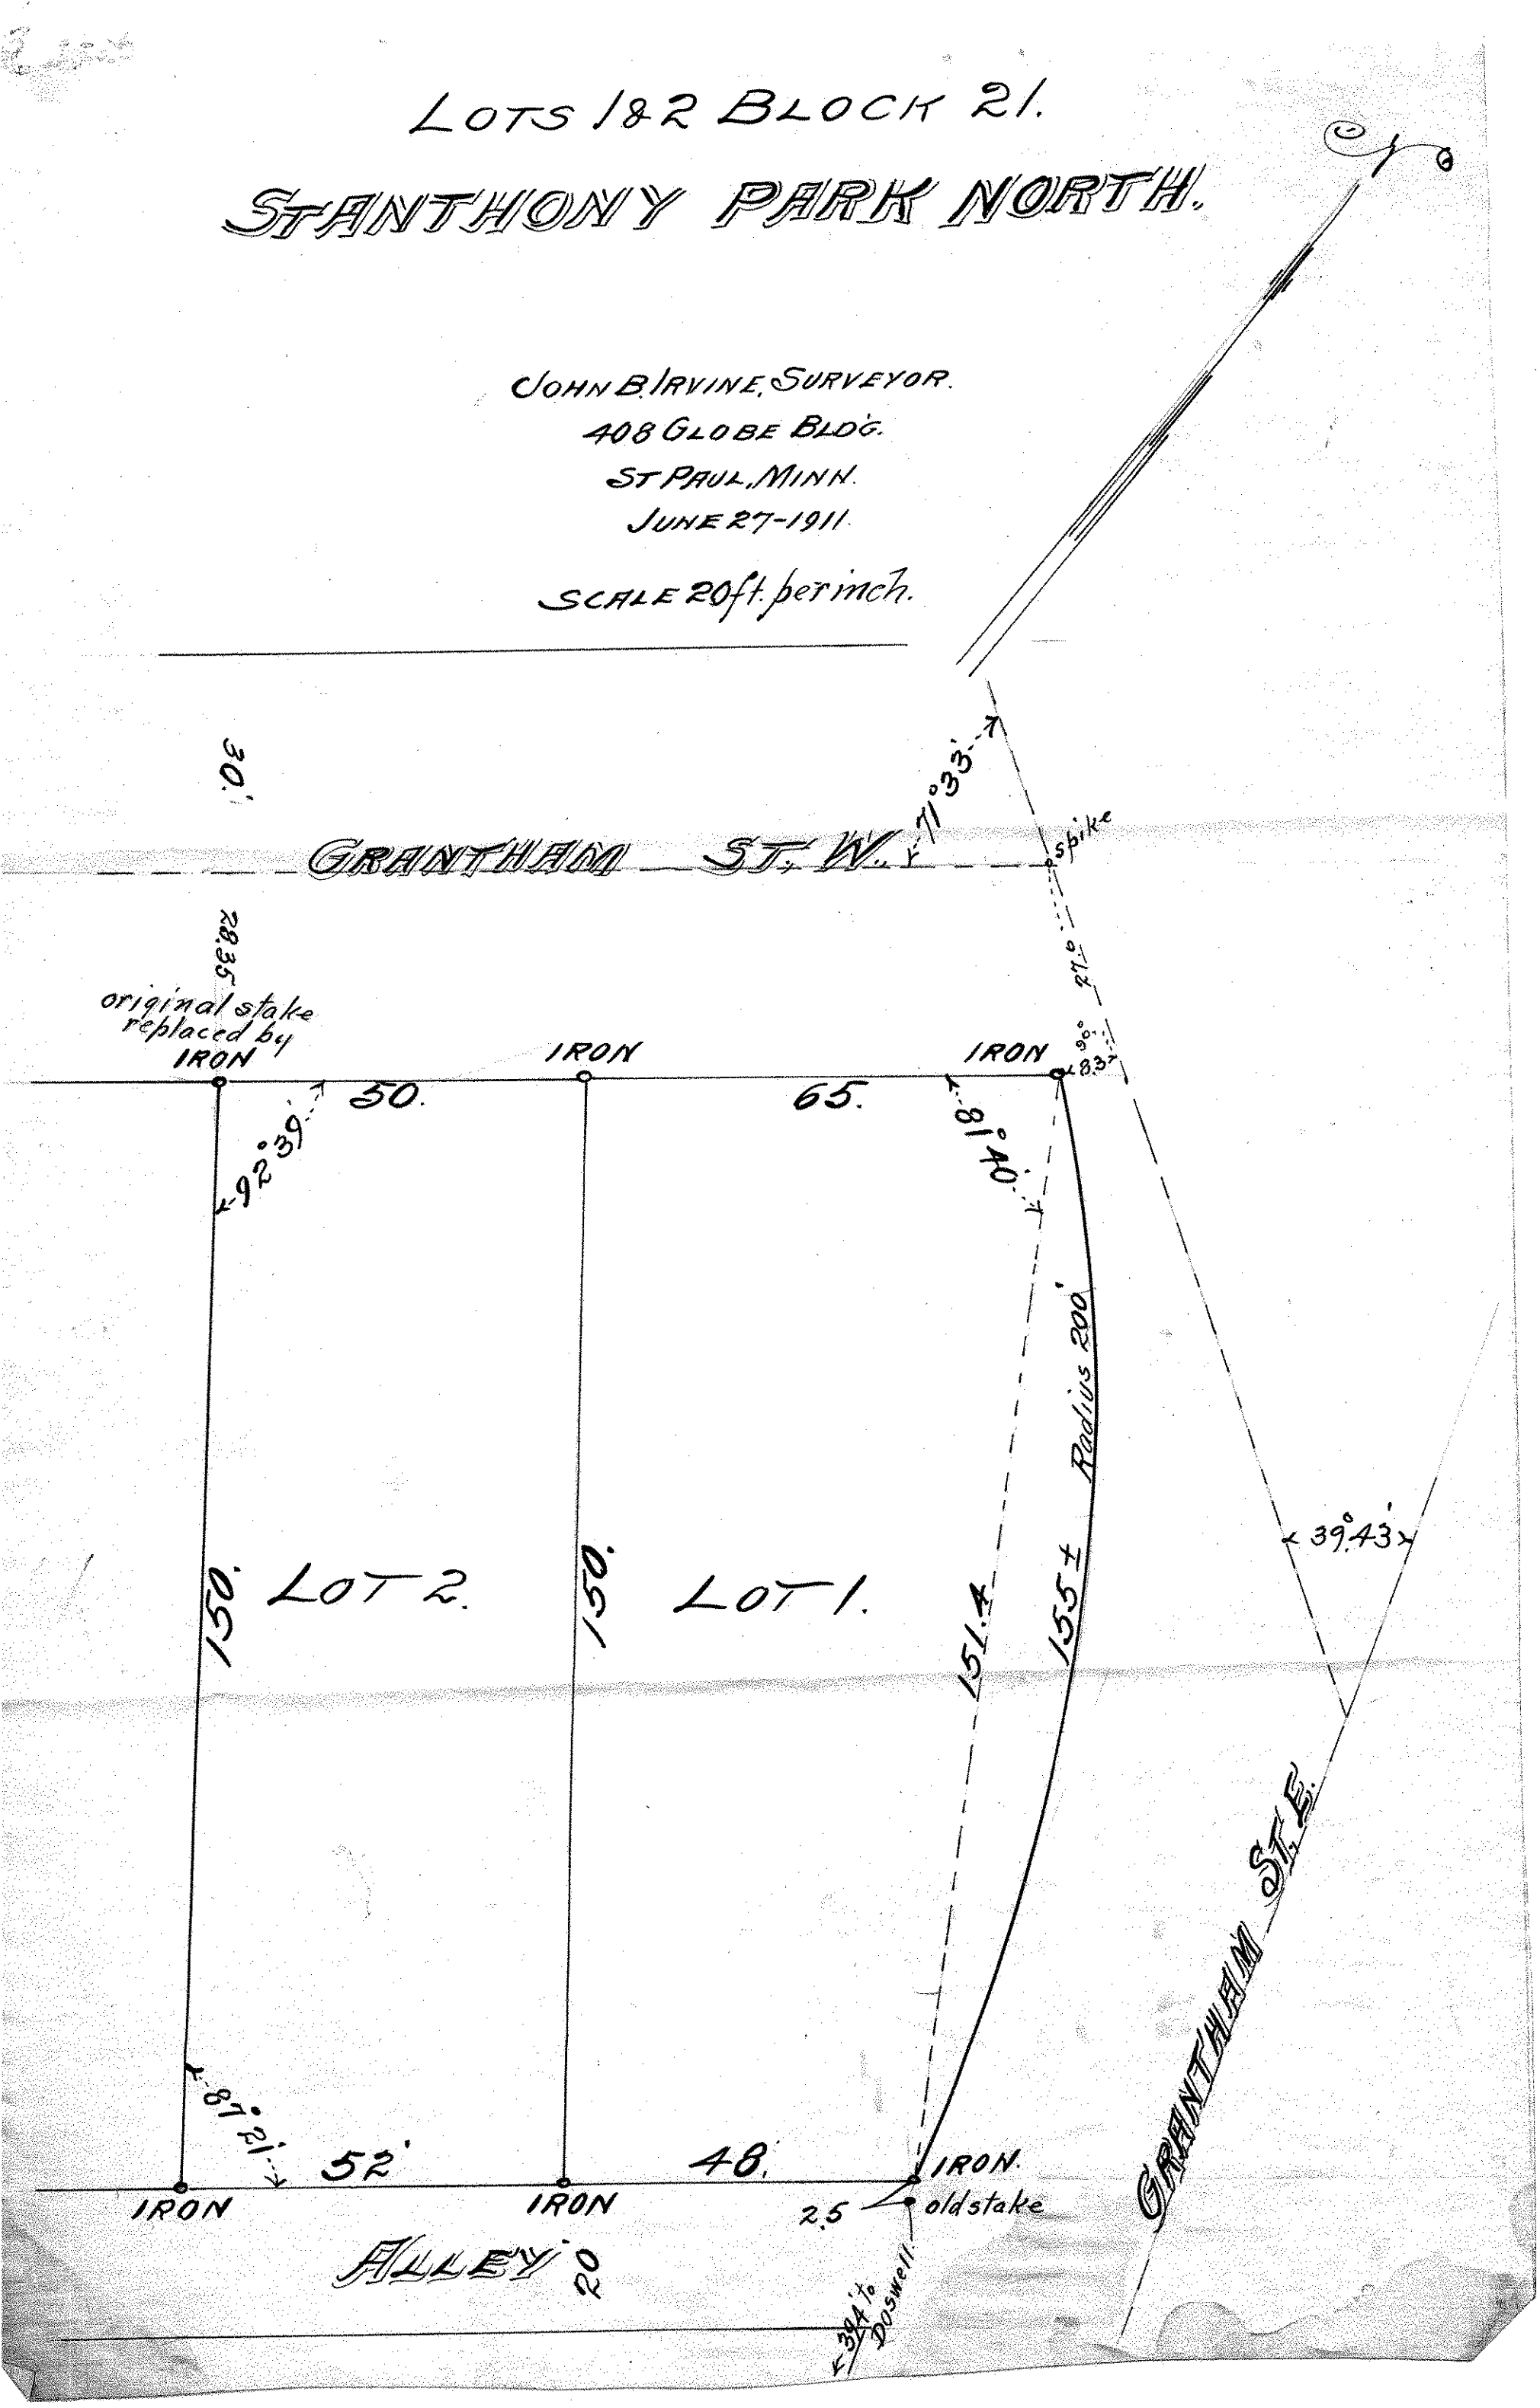
SCALE 20 ft. per inch.