

PLAT OF SURVEY

OF PROPERTY OF *Harold A. Oakins.*

DESCRIBED AS FOLLOWS *Lot 1, in Block 23 in "St Anthony Park North."*


No. 2360 Buford Avenue, St. Paul.

SCALE: 1 INCH *30* FEET.

T. J. WELCH, REGISTERED SURVEYOR
738 VAN BUREN PLACE ST. PAUL, MINN.

NORTH

BUFORD AVE.

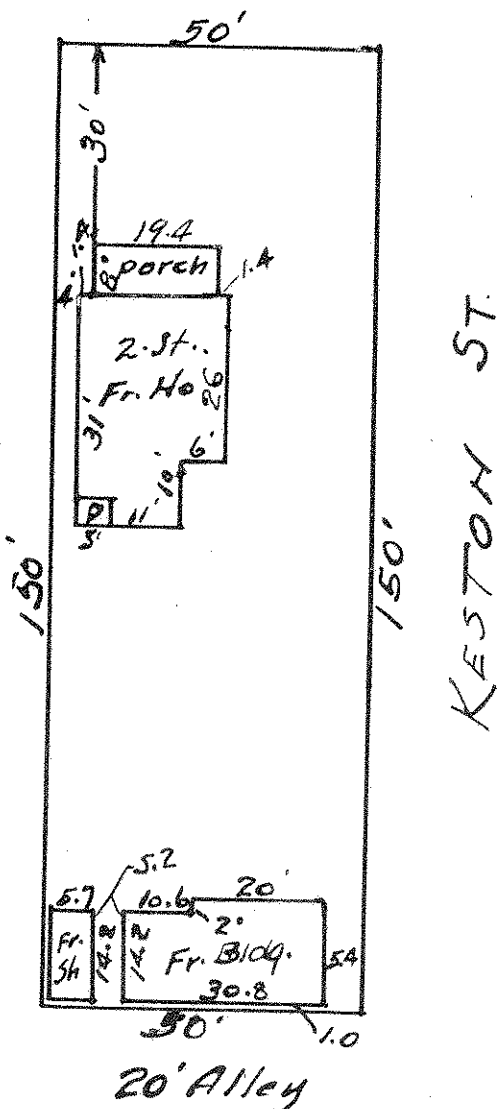

CERTIFICATE OF LOCATION OF BUILDING

I hereby certify that on *May 23* 19 *39*
I made a survey of the location of the building on the above described property and that the location of said building is correctly shown on the above plat.

T. J. Welch

CERTIFICATE OF SURVEY

I hereby certify that on *May 23* 19 *39*
I surveyed the property described above and that the above plat is a correct representation of said survey.

T. J. Welch