


PLAT OF SURVEY

OF PROPERTY OF _____

DESCRIBED AS FOLLOWS *Lot 8, Block 26, St Anthony Park North*

SCALE: 1 INCH 30 FEET
O DENOTES IRON

T. J. WELCH, REGISTERED SURVEYOR
738 SURREY AVENUE, ST. PAUL 6, MINN.

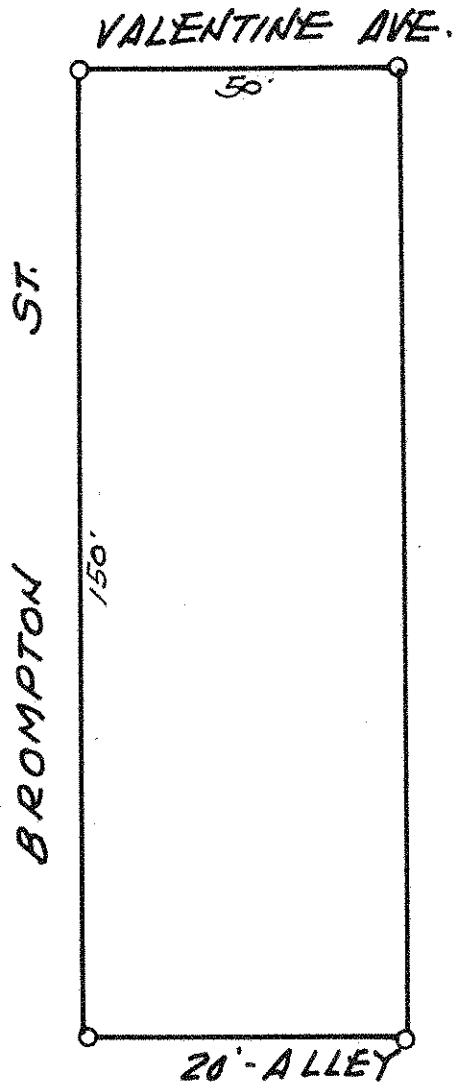

CERTIFICATE OF SURVEY

I hereby certify that on 4-12 19 54

I surveyed the property described above and that the above plat is a correct representation of said survey.

T. J. Welch