

PLAT OF SURVEY


OF PROPERTY OF *Clarence Smith*

DESCRIBED AS FOLLOWS *Lot 11, Block 28, St Anthony Park North,*

No. 1356 Eustis St; St. Paul, Minn

SCALE: 1 INCH 30 FEET

T. J. WELCH, REGISTERED SURVEYOR
738 SURREY AVENUE, ST. PAUL, MINN.

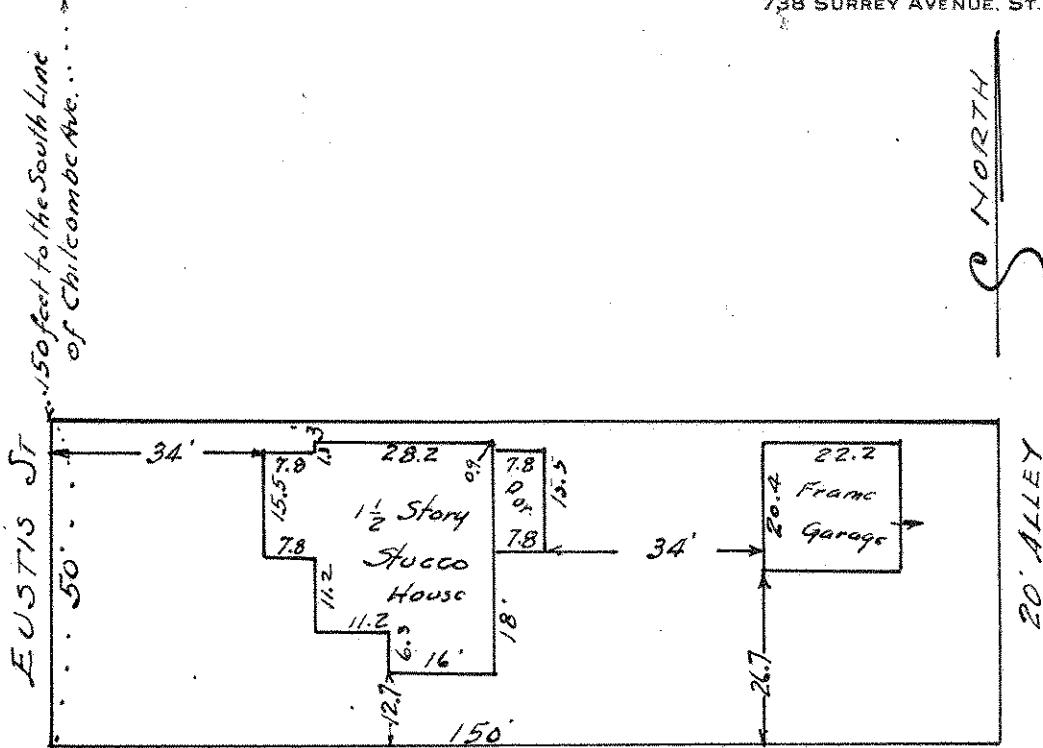

CERTIFICATE OF SURVEY

I hereby certify that on *July 7,* 19 *43.*
I surveyed the property described above and that the above
plat is a correct representation of said survey.

T. J. Welch