

App'l. No. 20969


TELEPHONE TOWER 0640

PLAT OF SURVEY

OF PROPERTY OF C. W. Michael - Leo M. Vargas (C.P.)
 DESCRIBED AS FOLLOWS Lot 3, Block 28, St. Anthony Park North, Ramsey
County, Minn.
No. 1359 Brompton Street - St. Paul, Minn.

SCALE: 1 INCH 30 FEET

T. J. WELCH, REGISTERED SURVEYOR
738 SURREY AVENUE, ST. PAUL 6, MINN.

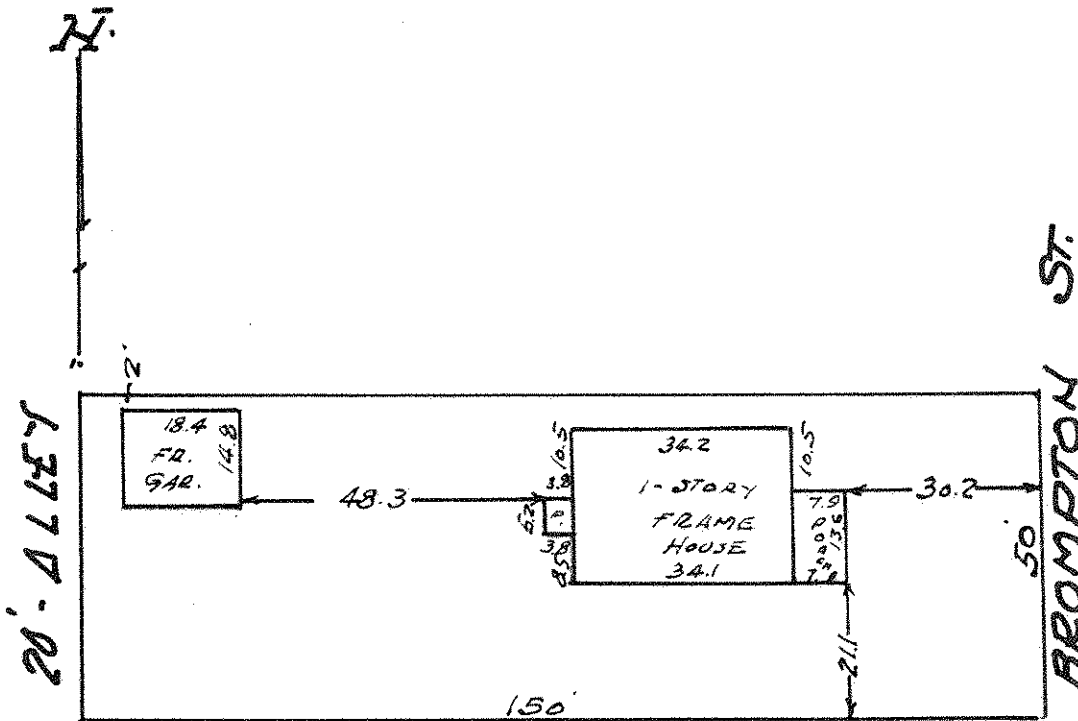

CERTIFICATE OF SURVEY

I hereby certify that on 9-11 1954
 I surveyed the property described above and that the above
 plat is a correct representation of said survey.

T. J. Welch