

# 4559

TELEPHONE TOWER C640

# PLAT OF SURVEY


OF PROPERTY OF Leonard C. Dose

DESCRIBED AS FOLLOWS Lot 13, Block 31, St. Anthony Park North

No. 2261 Carter Avenue, St. Paul, Minn.

SCALE: 1 INCH 40 FEET

T. J. WELCH, REGISTERED SURVEYOR  
738 SURREY AVENUE, ST. PAUL, MINN.

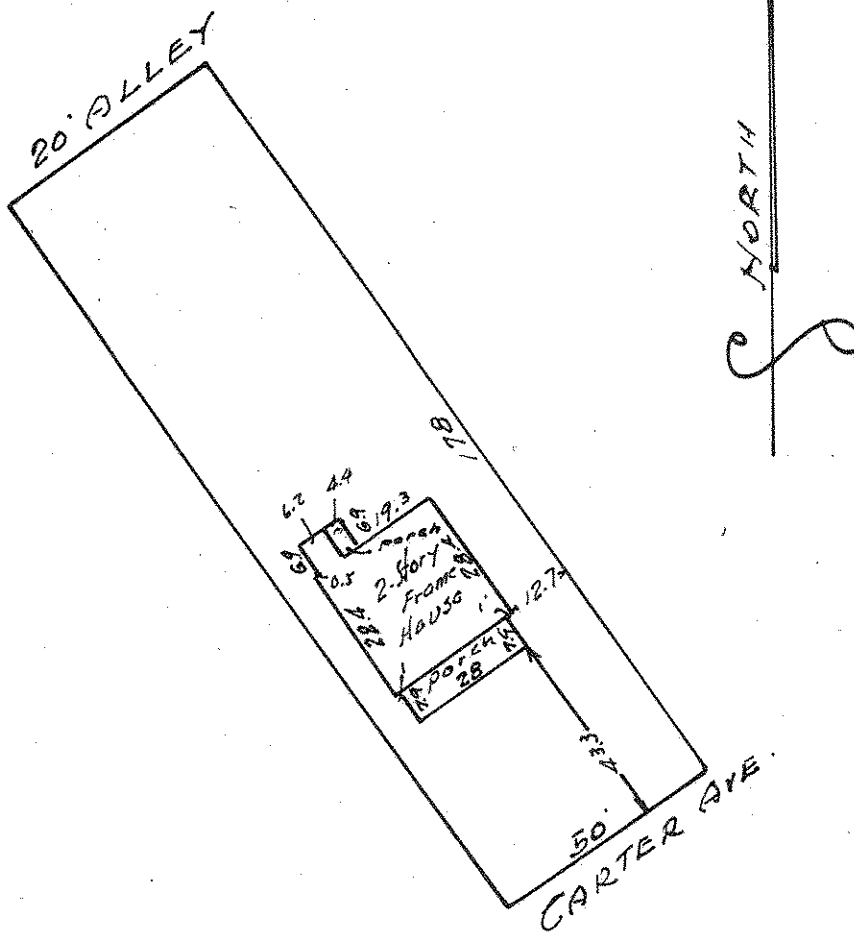

### CERTIFICATE OF SURVEY

I hereby certify that on June 8, 1944

I surveyed the property described above and that the above plat is a correct representation of said survey.

T. J. Welch