



PLAT OF SURVEY

OF PROPERTY OF _____

DESCRIBED AS FOLLOWS *Lot 11, Block 31, St. Anthony Park North
No. 2259 Carter Ave, St. Paul, Minn.*

SCALE: 1 INCH *30* FEET
○ Indicates Iron

T. J. WELCH, REGISTERED SURVEYOR
738 SURREY AVENUE, ST. PAUL, MINN.

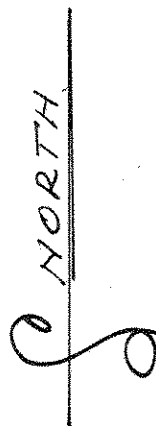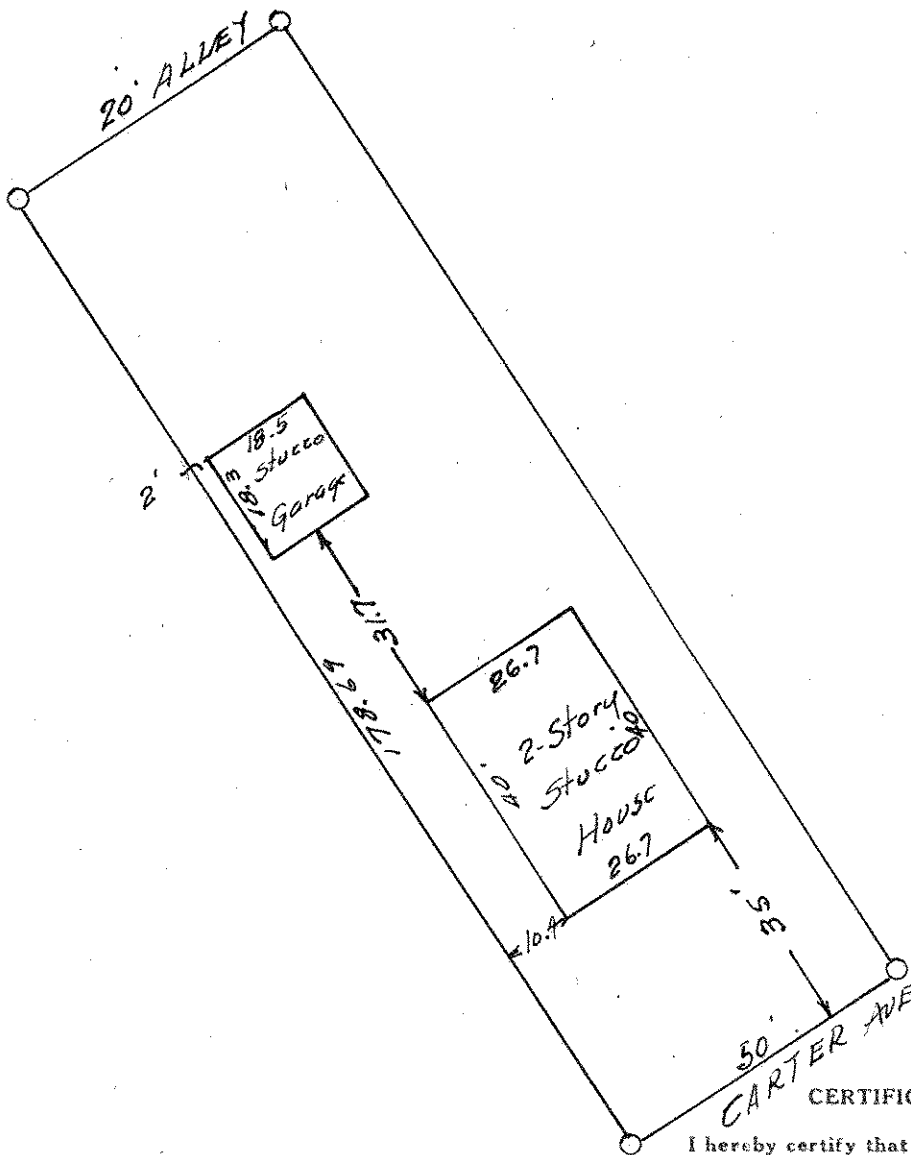

CERTIFICATE OF SURVEY

I hereby certify that on *July 28,* 19*43,*

I surveyed the property described above and that the above plat is a correct representation of said survey.

T. J. Welch