

LOTS 21 & 22 BLOCK 31.


ST. ANTHONY PARK NORTH.

JOHN B. IRVINE SURVEYOR
ROOM 416 GLOBE BLDG.
ST PAUL MINN.

SCALE 1 IN. = 20 FT.

SEPT. 25-06.

20 ALLEY

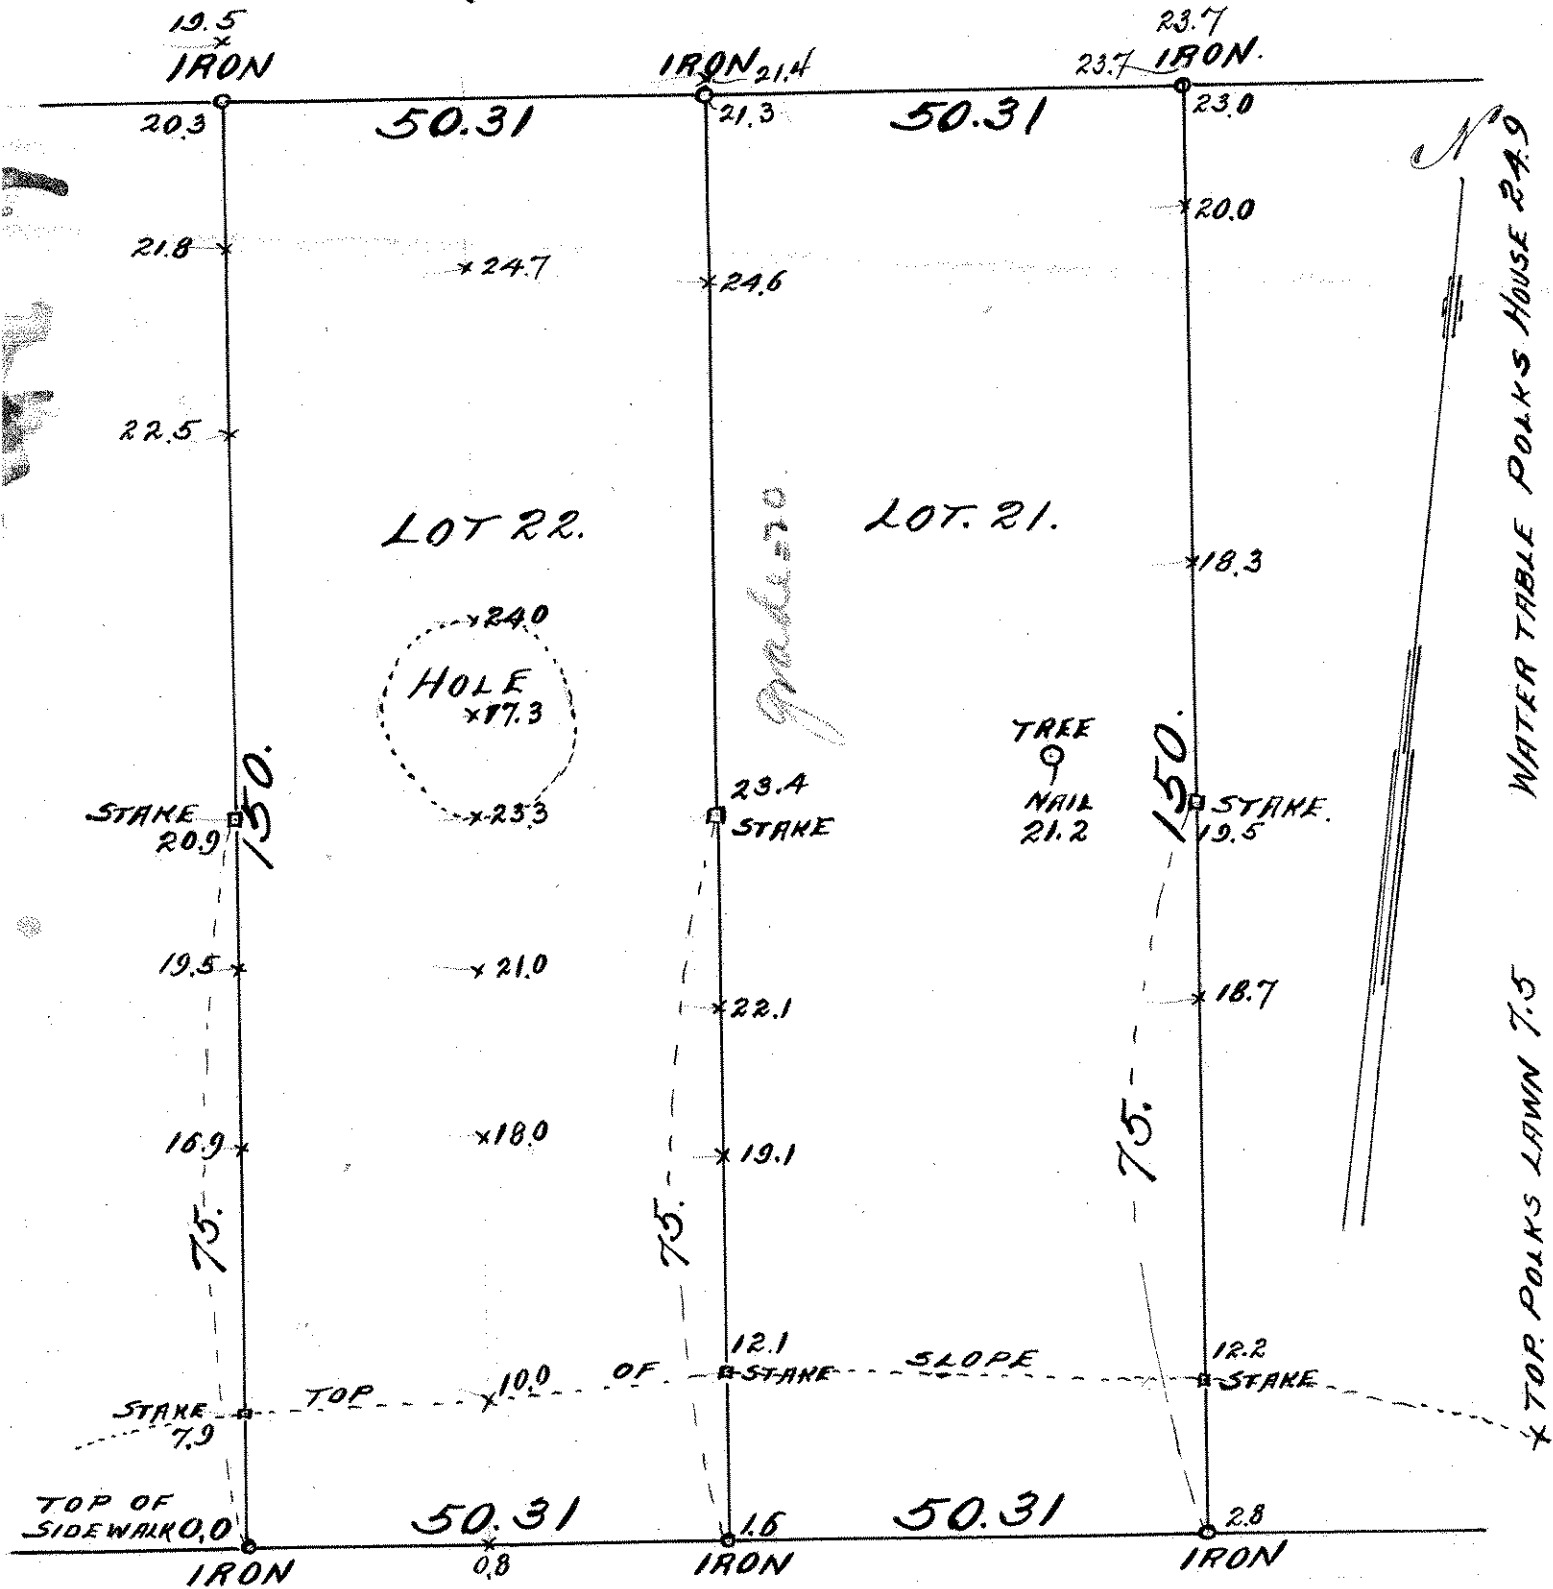

WESTON ST