2

Appl. 47825

TELEPHONE 776-0640

PLAT OF SURVEY

OF PROPERTY OF Orin J. Anderson

DESCRIBED AS FOLLOWS Lot 3, Block 33, St. Anthony Park North
№ 1385 Raymond Ave, St. Paul, Minnesota.

SCALE: 1 INCH = 30 FEET

T. J. WELCH, REGISTERED SURVEYOR
701 EAST 3RD STREET, ST. PAUL, MINN. 55106

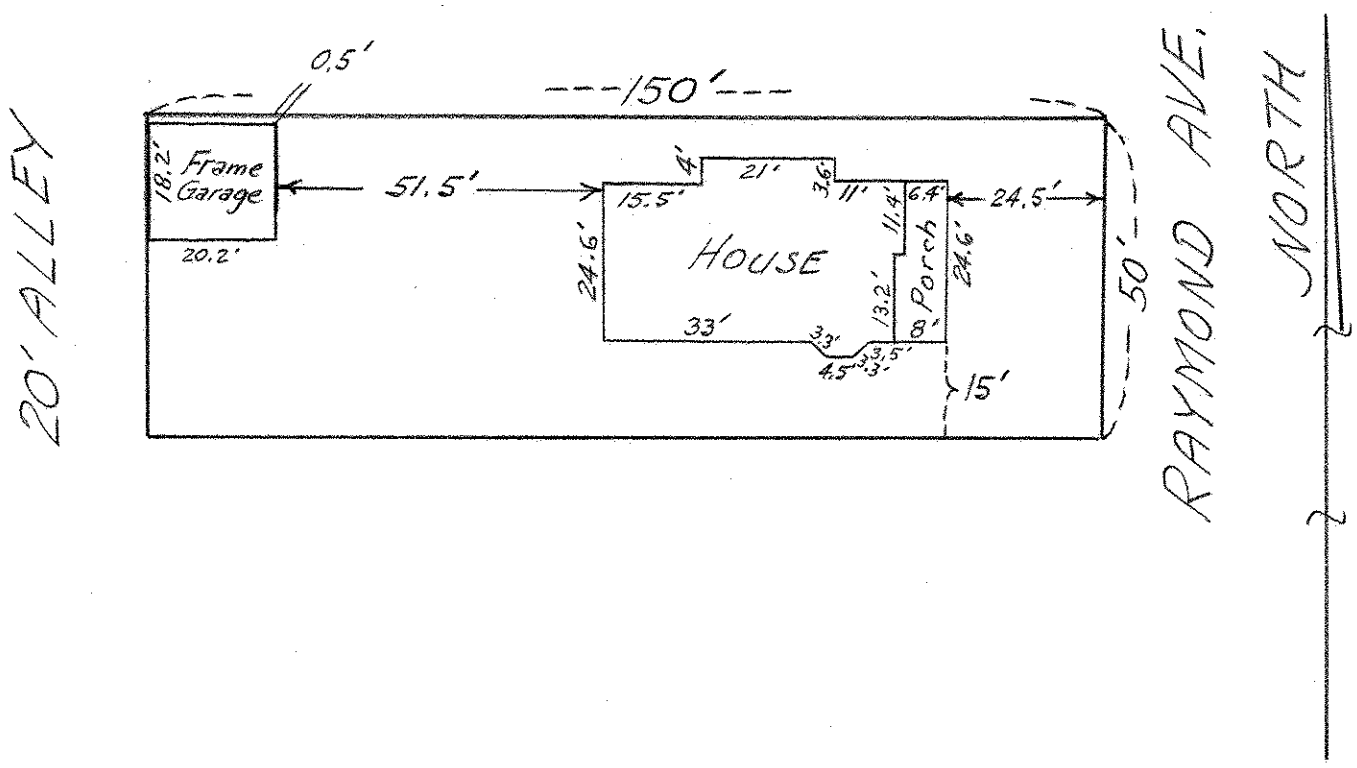

This survey is made exclusively for First Federal Savings & Loan Assn. of St. Paul; Lot lines are not guaranteed as this is survey for mortgage purposes only.

CERTIFICATE OF SURVEY

I hereby certify that on May 13, 1967 I surveyed the property described above and that the above plat is a correct representation of said survey.

T. J. Welch

326/17