


LOT 7 BLOCK 34
ST ANTHONY PARK
NORTH.

JOHN B. IRVINE, SURVEYOR.

ST. PAUL, MINN.

APRIL 17-1915.

scale 20ft. per inch.

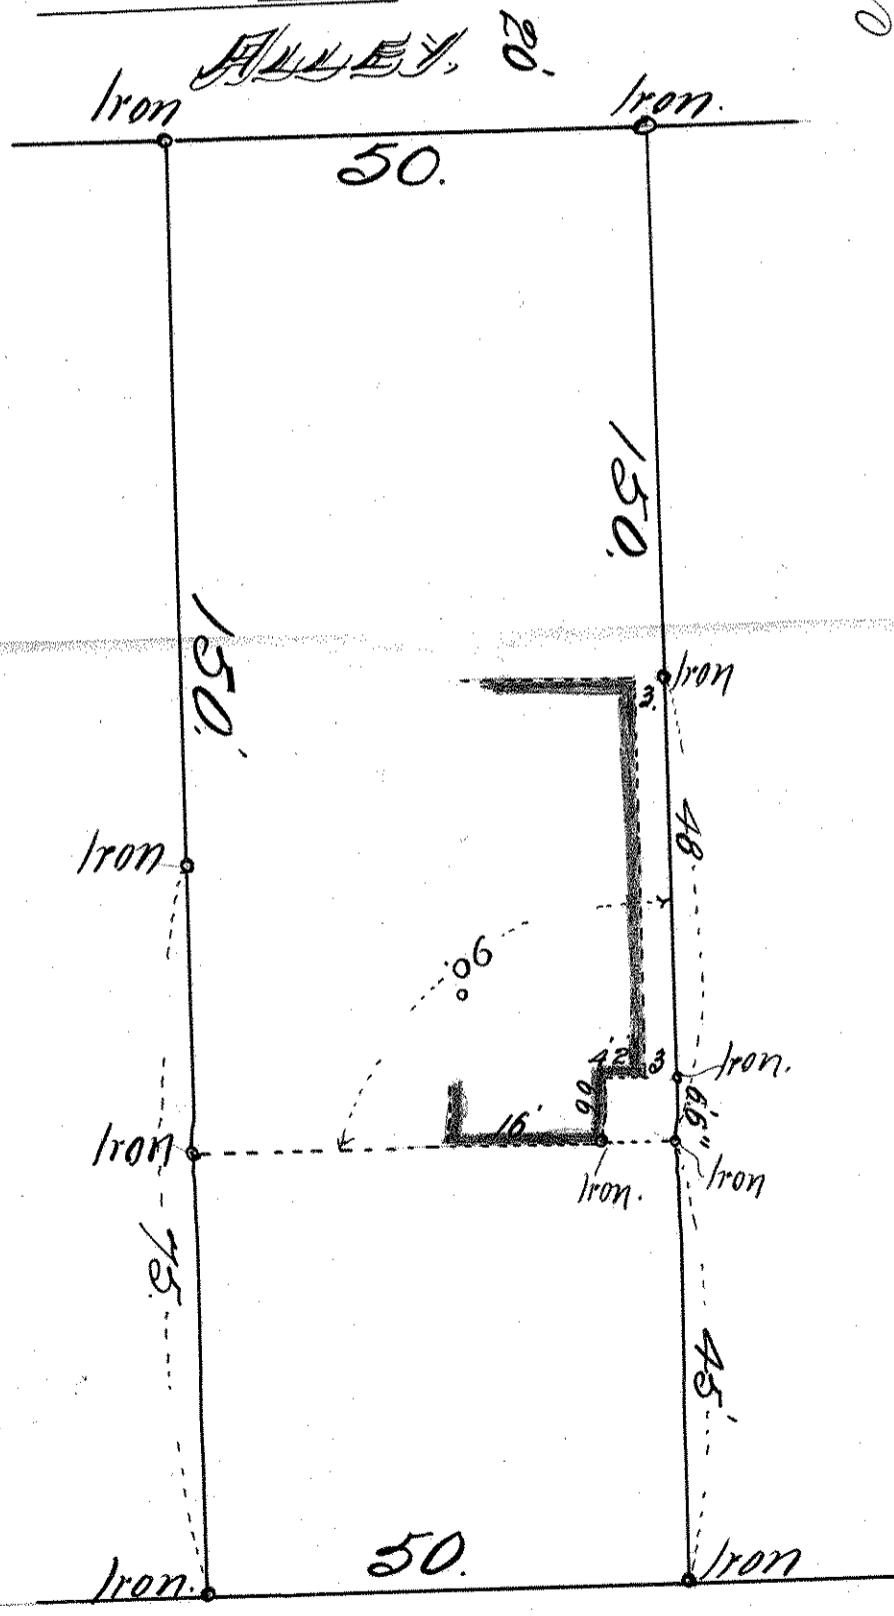

CLEVELAND AVE.