

PLAT OF SURVEY


OF PROPERTY OF Ommund Nielsen.

DESCRIBED AS FOLLOWS Lot numbered 18 in Block numbered 36, St. Anthony Park North.

No. 2095 Commonwealth Avenue, St. Paul, Minn.

SCALE: 1 INCH 30 FEET.

T. J. WELCH, REGISTERED SURVEYOR
738 VAN BUREN PLACE, ST. PAUL, MINN.

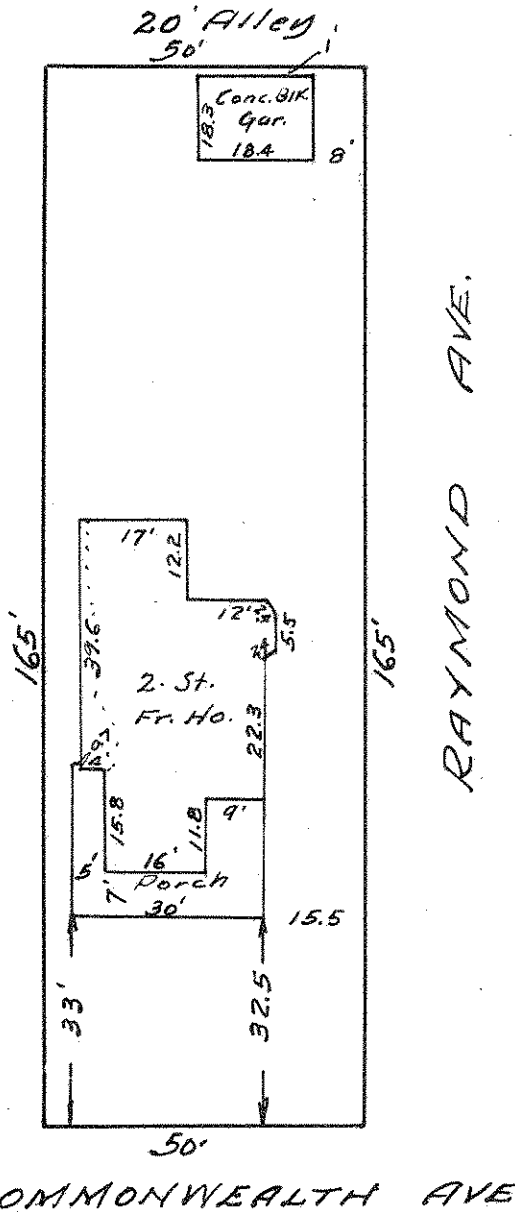

CERTIFICATE OF LOCATION OF BUILDING

I hereby certify that on June 19, 1939
I made a survey of the location of the building on the above
described property and that the location of said building is
correctly shown on the above plat.

T. J. Welch

CERTIFICATE OF SURVEY

I hereby certify that on June 19, 1939
I surveyed the property described above and that the above
plat is a correct representation of said survey.

T. J. Welch