

LOT 14 BLOCK 38.

ST ANTHONY PARK NORTH.


JOHN B. IRVINE SURVEYOR.

ROOM 508 GLOBE BLDG

SCALE 20'-1"

ST PAUL MINN.

APRIL 21-05

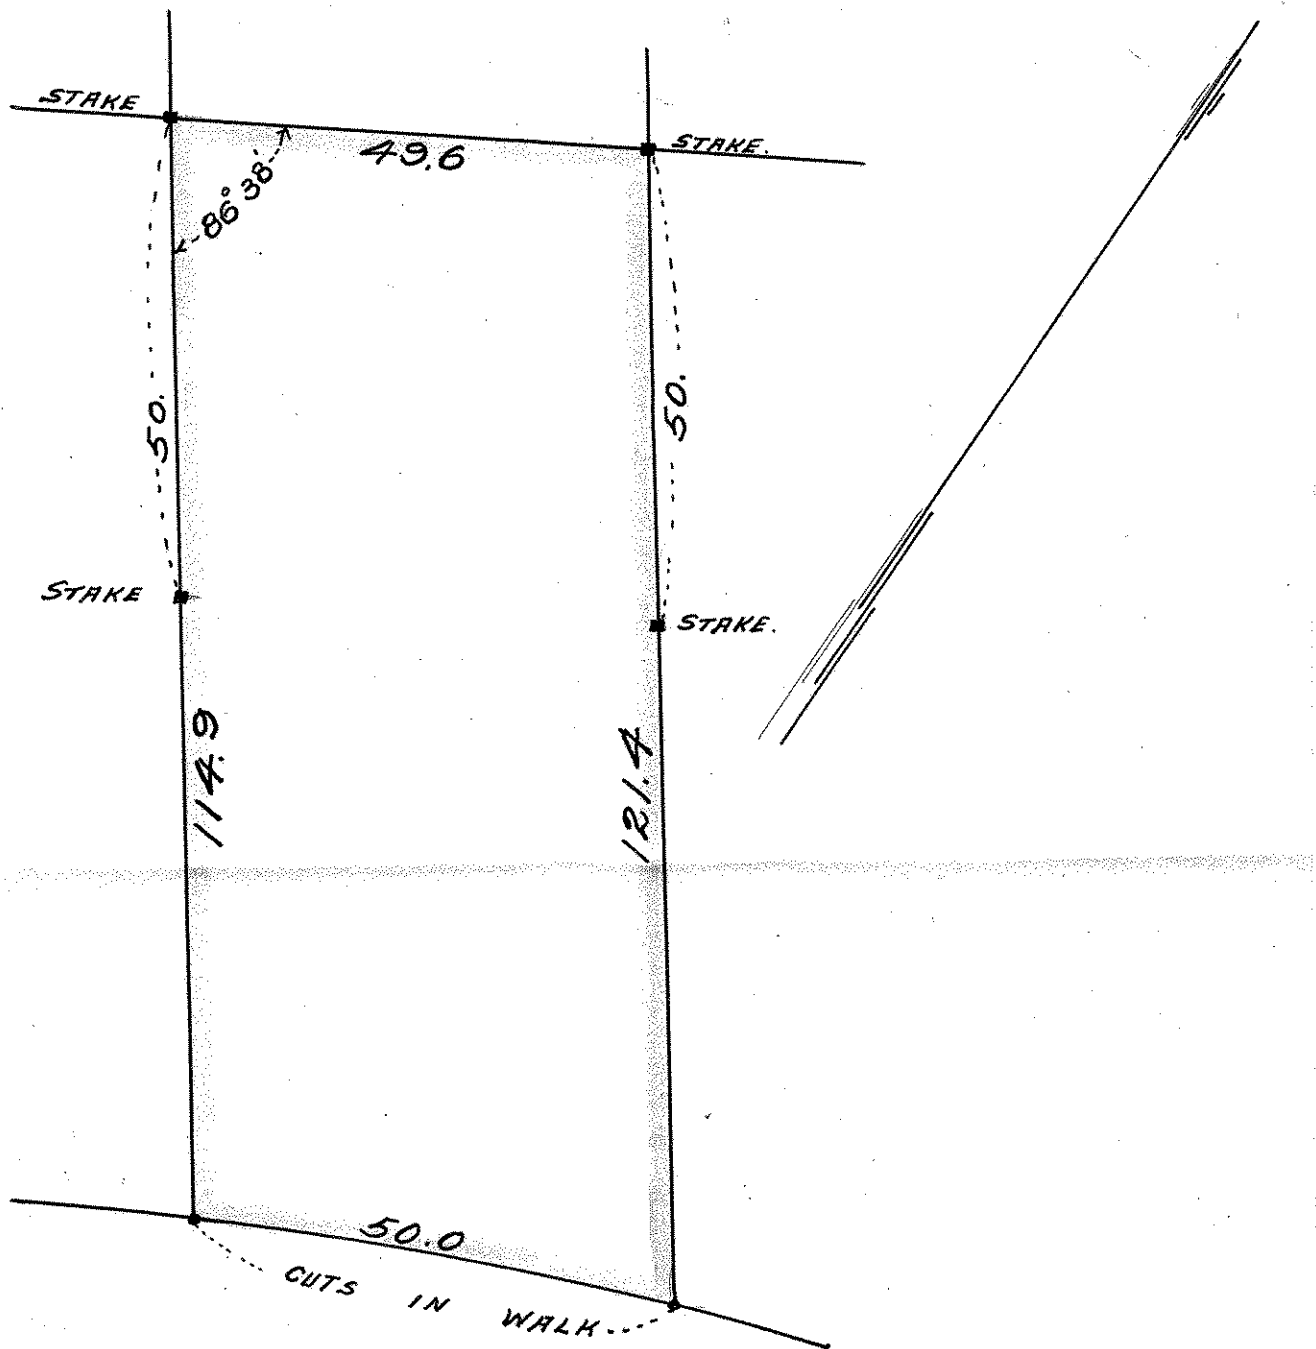

COMMONWEALTH AVE.