THE NORTHEASTERLY 7 ft.
LOT 6 BLOCK 39.
ST ANTHONY PARK
NORTH.
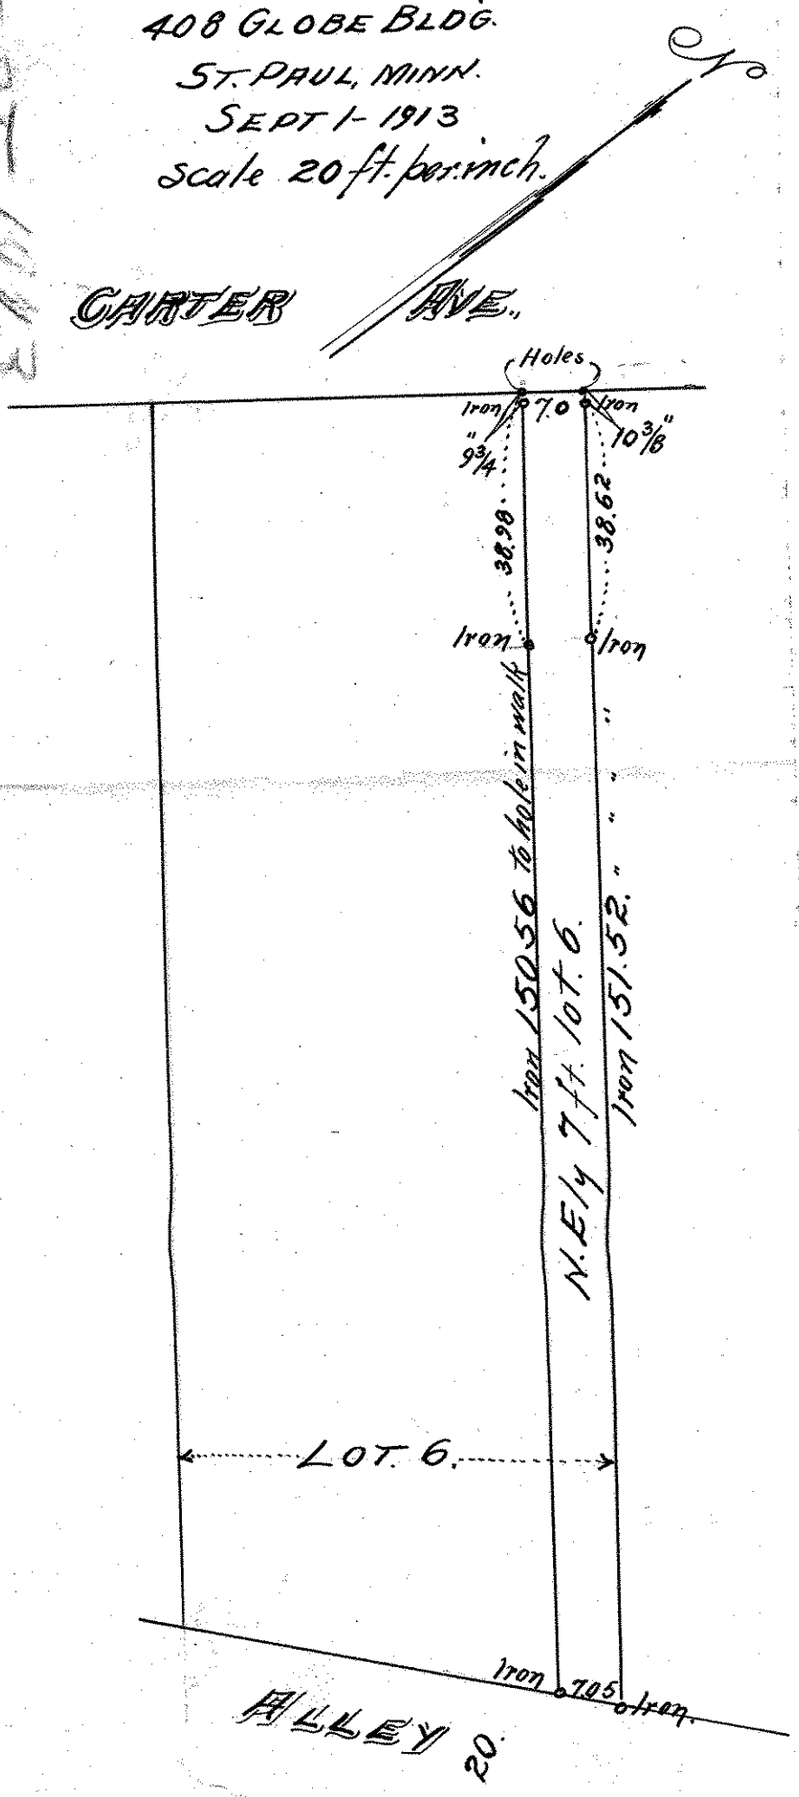
JOHN B. IRVINE, SURVEYOR.
408 GLOBE BLDG.
ST. PAUL, MINN.
SEPT 1- 1913
scale 20 ft. per inch.