

Appl. 57299

TELEPHONE 776-0640

PLAT OF SURVEY


OF PROPERTY OF Roy J. Hagen

DESCRIBED AS FOLLOWS Lot 10, Block 42, St. Anthony Park North
No 2333 Hillside Ave., St. Paul, Minnesota.

SCALE: 1 INCH = 30 FEET

T. J. WELCH, REGISTERED SURVEYOR
701 EAST 3RD STREET, ST. PAUL, MINN. 55106

20' ALLEY
VACATED

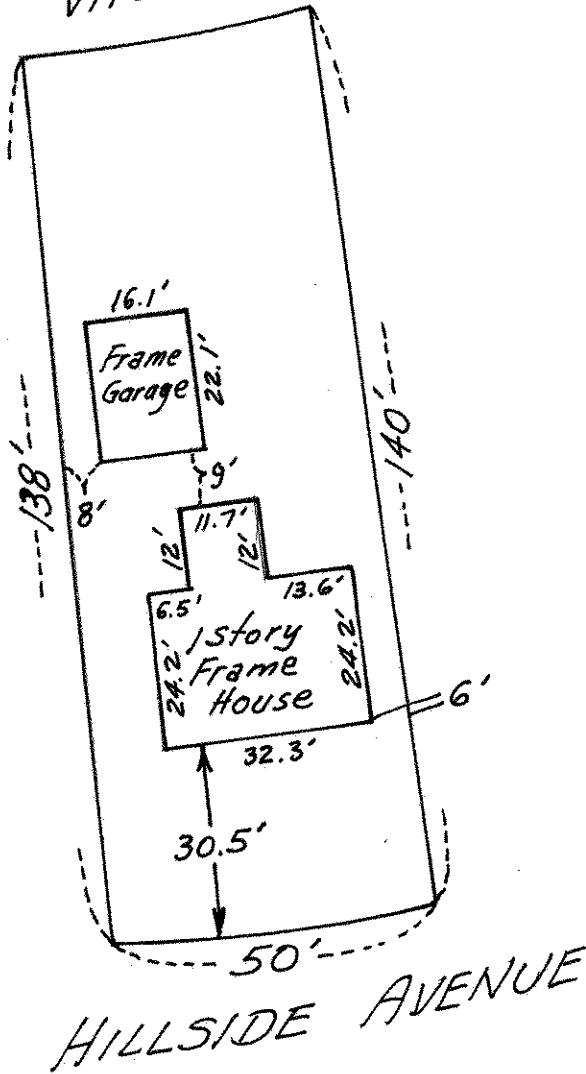

This survey is made exclusively for First Federal Savings and Loan Assn. of St. Paul, Minn. Lot lines are not guaranteed as this is survey for mortgage purposes only.

CERTIFICATE OF SURVEY

I hereby certify that on July 6, 1973
I surveyed the property described above and that the above plat is a correct representation of said survey.

T. J. Welch