


LOTS 6 & 7 BLOCK 6.

ST ANTHONY PARK WEST,

JOHN B. IRVINE, SURVEYOR.

JULY 28-1910.

N

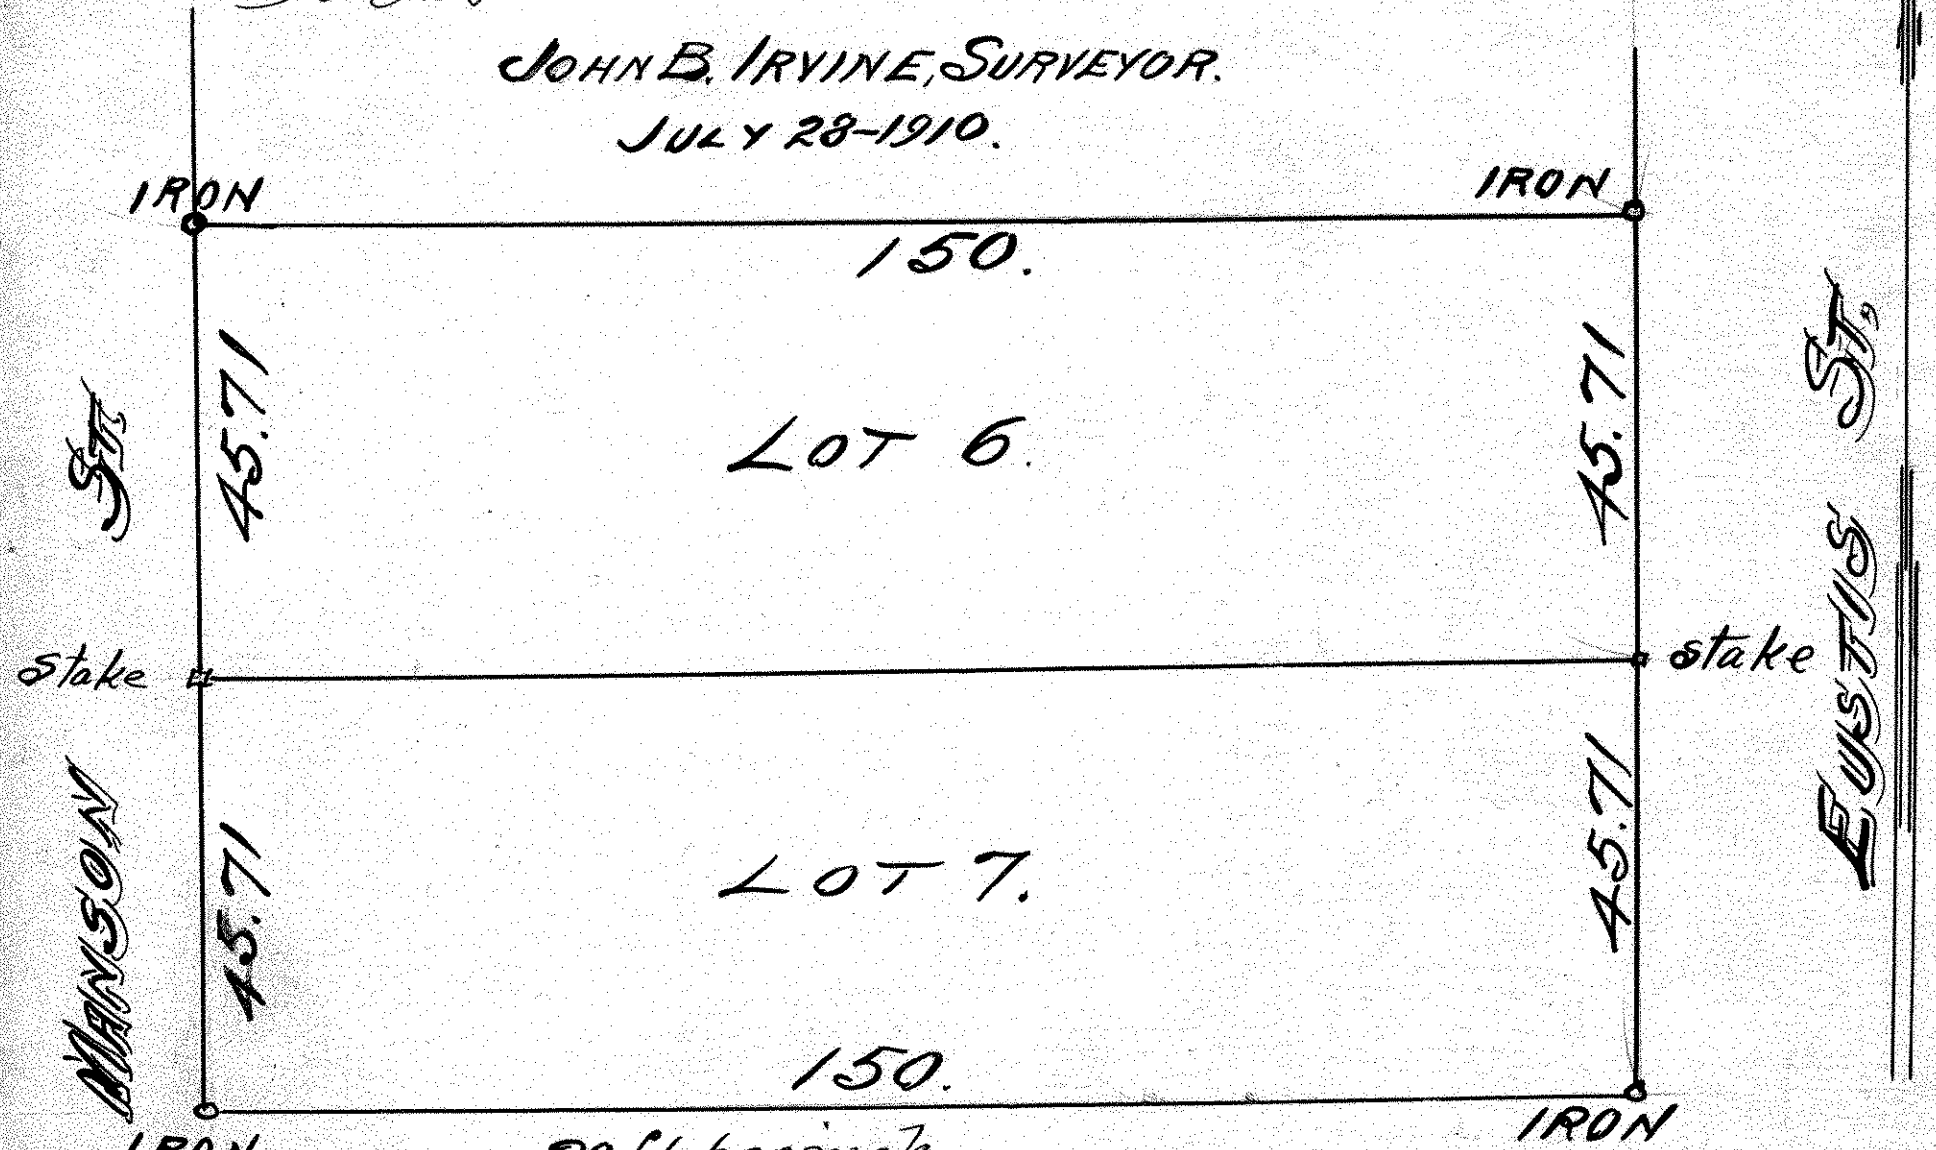

stake

stake

IRON SCALE 20ft per inch.

CHILGOMBE AVE.