

LOT 5 BLOCK 2

ST CLAIR ST. &

SHORT LINE,
ADDITION.


JOHN B. IRVINE, SURVEYOR.

408 GLOBE BLDG.

ST PAUL MINN.

SEPT 8-1909.

SCALE 20ft per. inch.

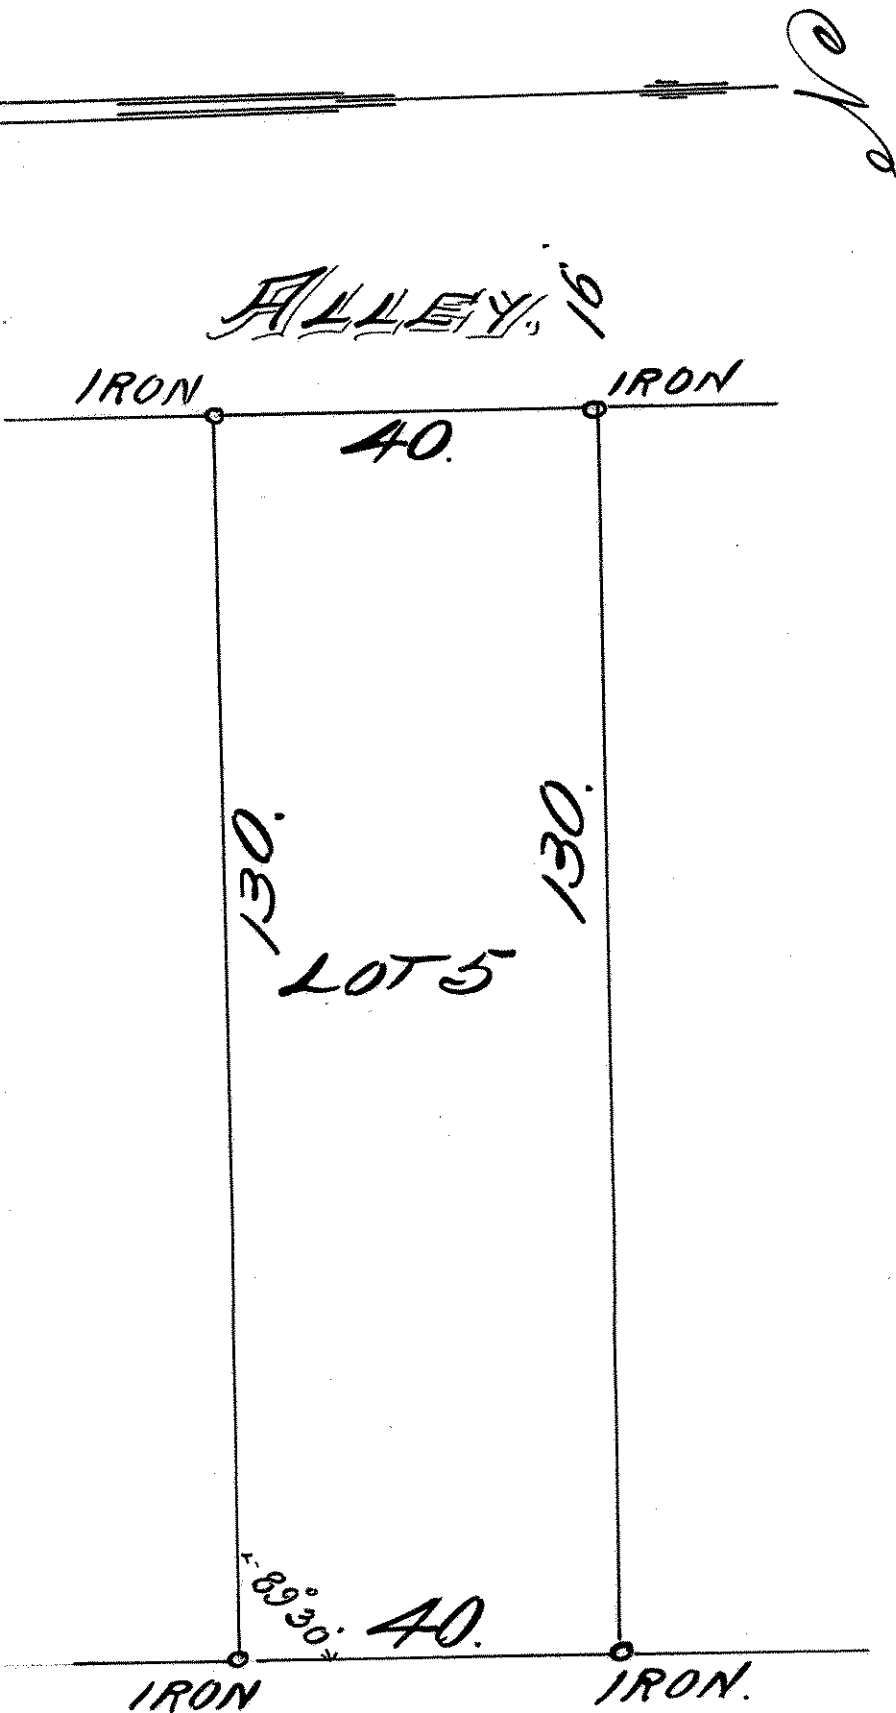

LEXINGTON AVE.