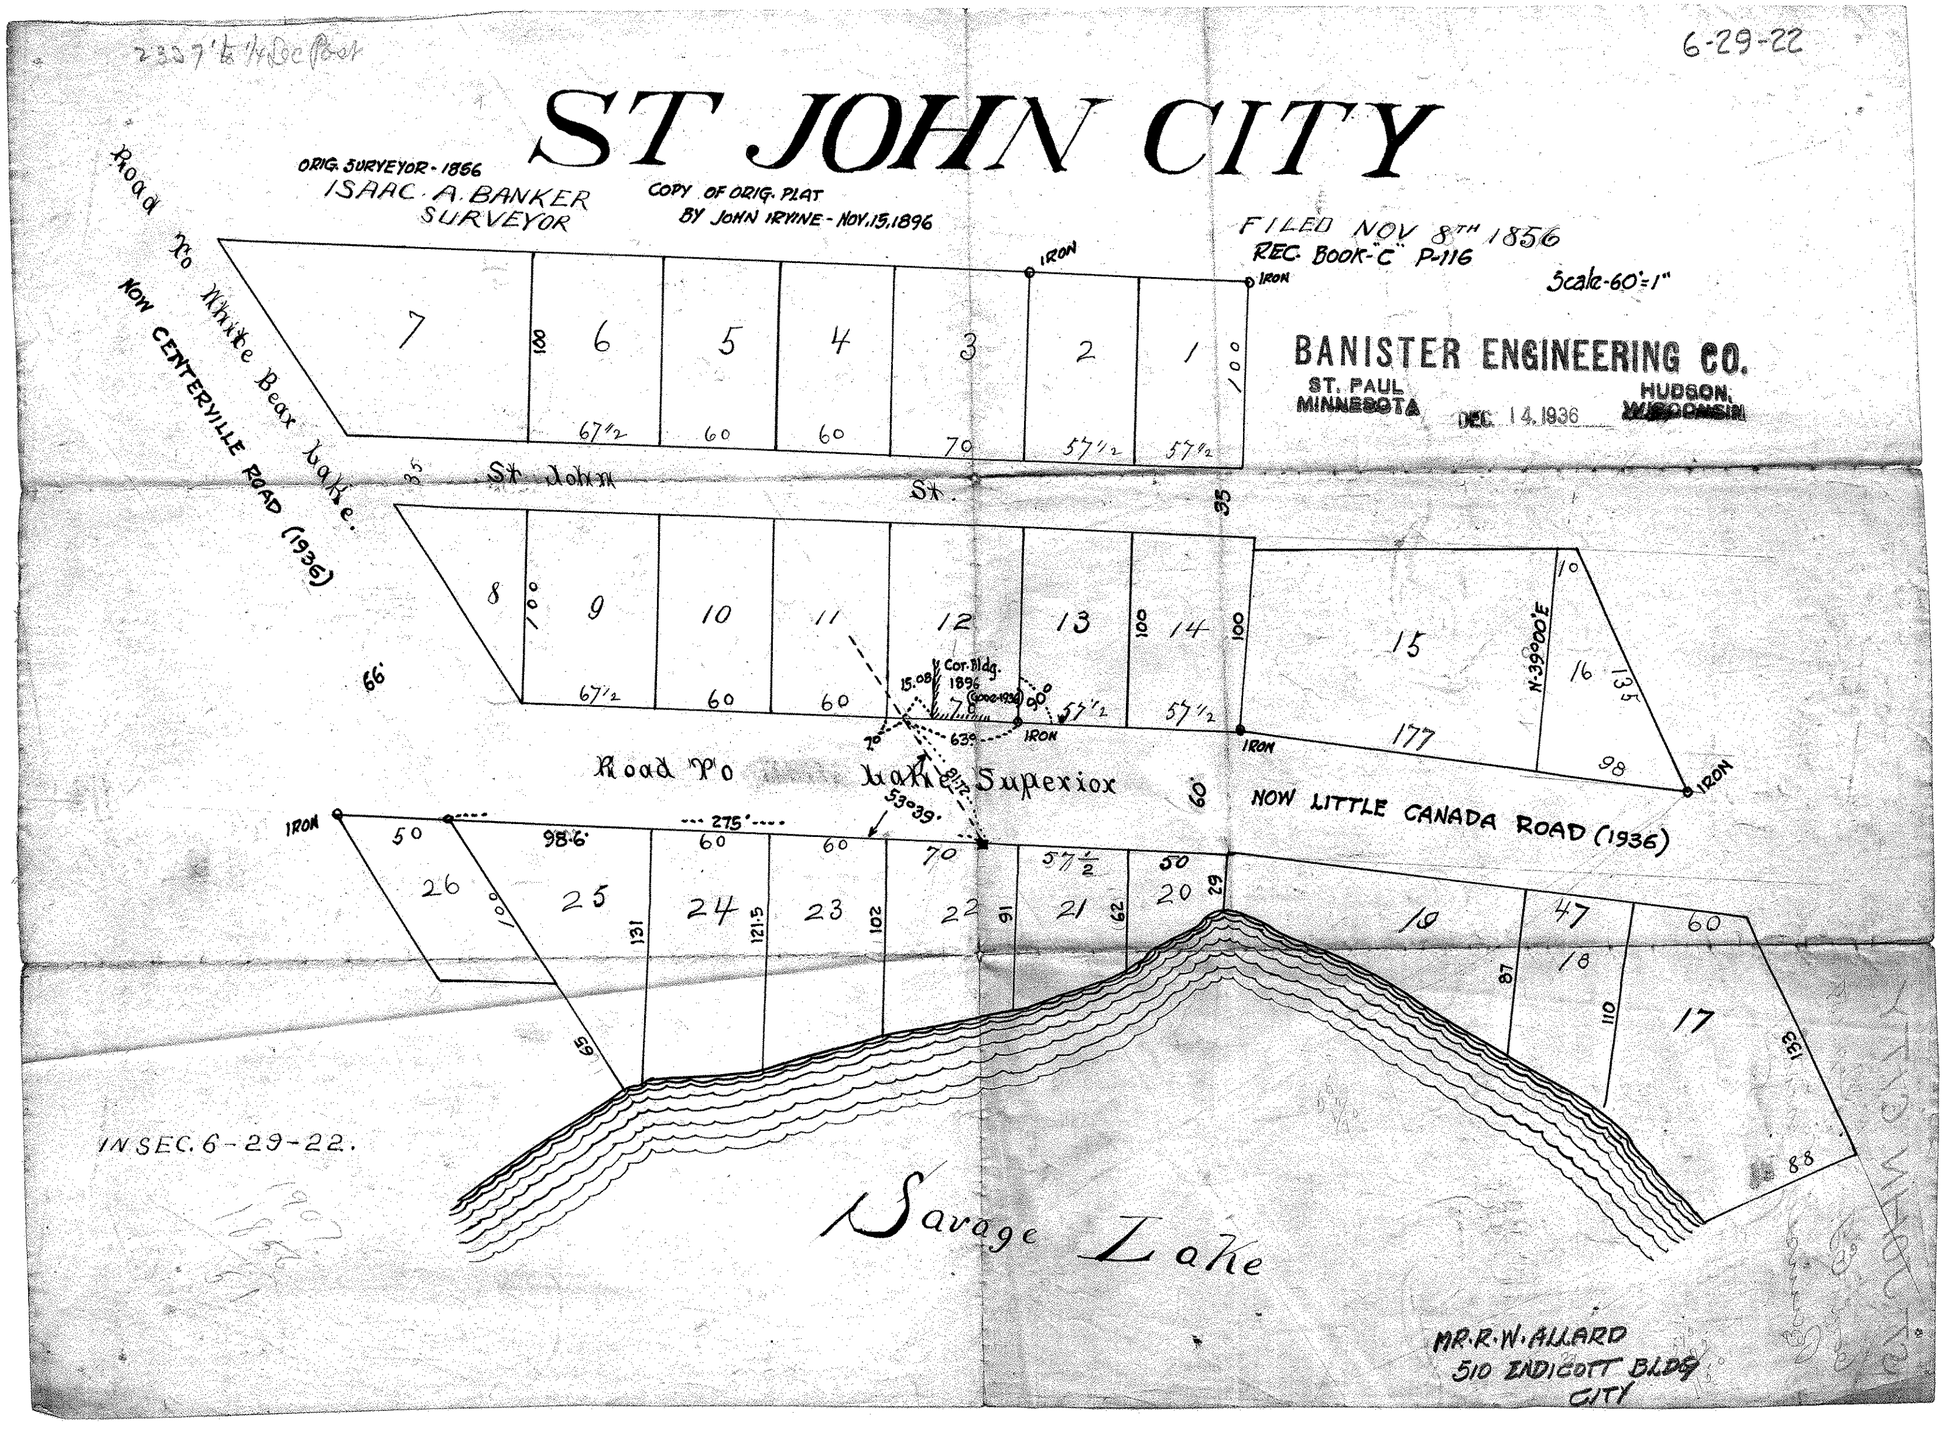

2337' to 1/4 Sec Post
6-29-22
ST JOHN CITY
ORIG. SURVEYOR - 1856
ISAAC A. BANKER
SURVEYOR
COPY OF ORIG. PLAT
BY JOHN IRVINE - NOV. 15, 1896
FILED NOV 8TH 1856
REC. BOOK "C" P-116
Scale-60'=1"
BANISTER ENGINEERING CO.
ST. PAUL
MINNESOTA
HUDSON,
WISCONSIN
DEC. 14, 1936
Road To White Bear Lake.
NOW CENTERVILLE ROAD (1936)
St. John St.
Road To Lake Superior
NOW LITTLE CANADA ROAD (1936)
Cor. Bldg. 1896
IRON
N-39°00'E
Savage Lake
IN SEC. 6-29-22.
MR. R. W. ALLARD
510 INDICOTT BLDG
CITY