

SOUTHERLY $\frac{1}{6}$ OF LOTS 5 & 6 BLOCK 19
ST. PAUL PROPER.

Scale 10 feet per inch.

JOHN B. IRVINE
SURVEYOR

ST.

60


FIFTH

Lot 5

Lot 6

Stone and Brick Building.

UNION BLOCK

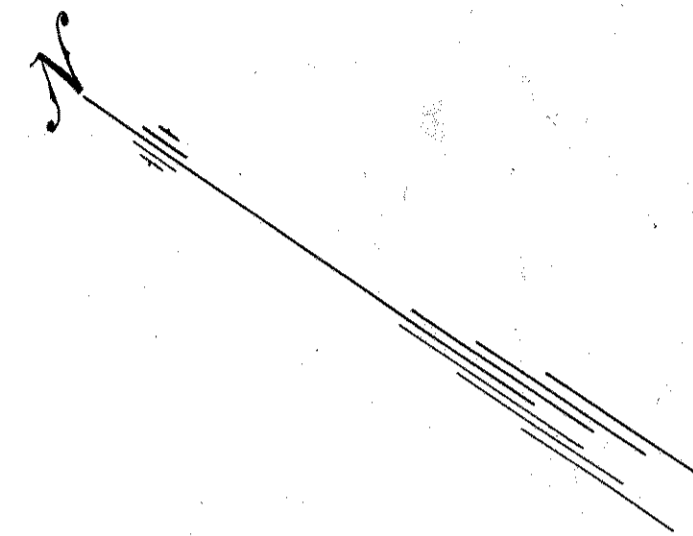

St. Paul, Minn, March 21st 1902.
I hereby certify that this diagram
correctly represents "THE SOUTHERLY $\frac{1}{6}$ OF"
LOTS 5 & 6 BLOCK 19, ST. PAUL PROPER
as surveyed by me this day.
John B. Irvine
County Surveyor
Room 16 Court House.

JOHN B. IRVINE.
Co. Surveyor, R. 16, Court House

60

CEDAR

ST.

