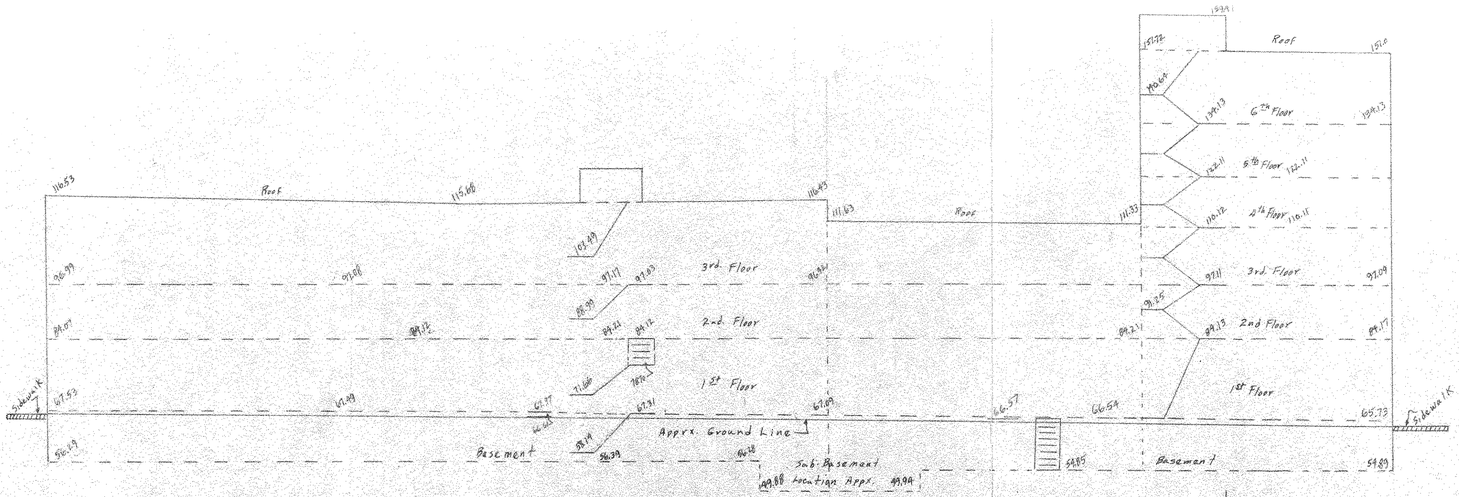

Building Profile - Elevations taken near Southly Face

SEE SHEET # 1

NOTES:

All Elevations are City Datum
BM = 66.58 Top Hydrant at S.W. Corner 6th and Robert St.
BM = 68.93 Top Hydrant at N.W. Corner 7th and Robert St.
BM = 69.88 Top Hydrant at S.W. Corner 7th and Minnesota St.
BM = 68.82 Top Hydrant at S.E. Corner 6th and Minnesota (on 6th)

All utilities as per public record and to accuracy of same. See Sheet #1 for additional utilities.

—E— Denotes underground Electric Ducts
—S— Denotes underground Steam Lines
—WU— Denotes Western Union
- - - Denotes underground Area Ways

There may be unrecorded Utility lines in this old part of town. Call N.S.P. Bell Telephone and ~~other underground utility~~ Companies prior to Construction for exact field location.

*TENATIVE NEGOTATIONS:

Robert St - Widening of 11' from 6th St. to South face of Bank Building (approx 172')

6th ST. - Widening of 2' from axisting Robert St for 130' toward Minnesota St. then 13 feet widening to Minnesota St.

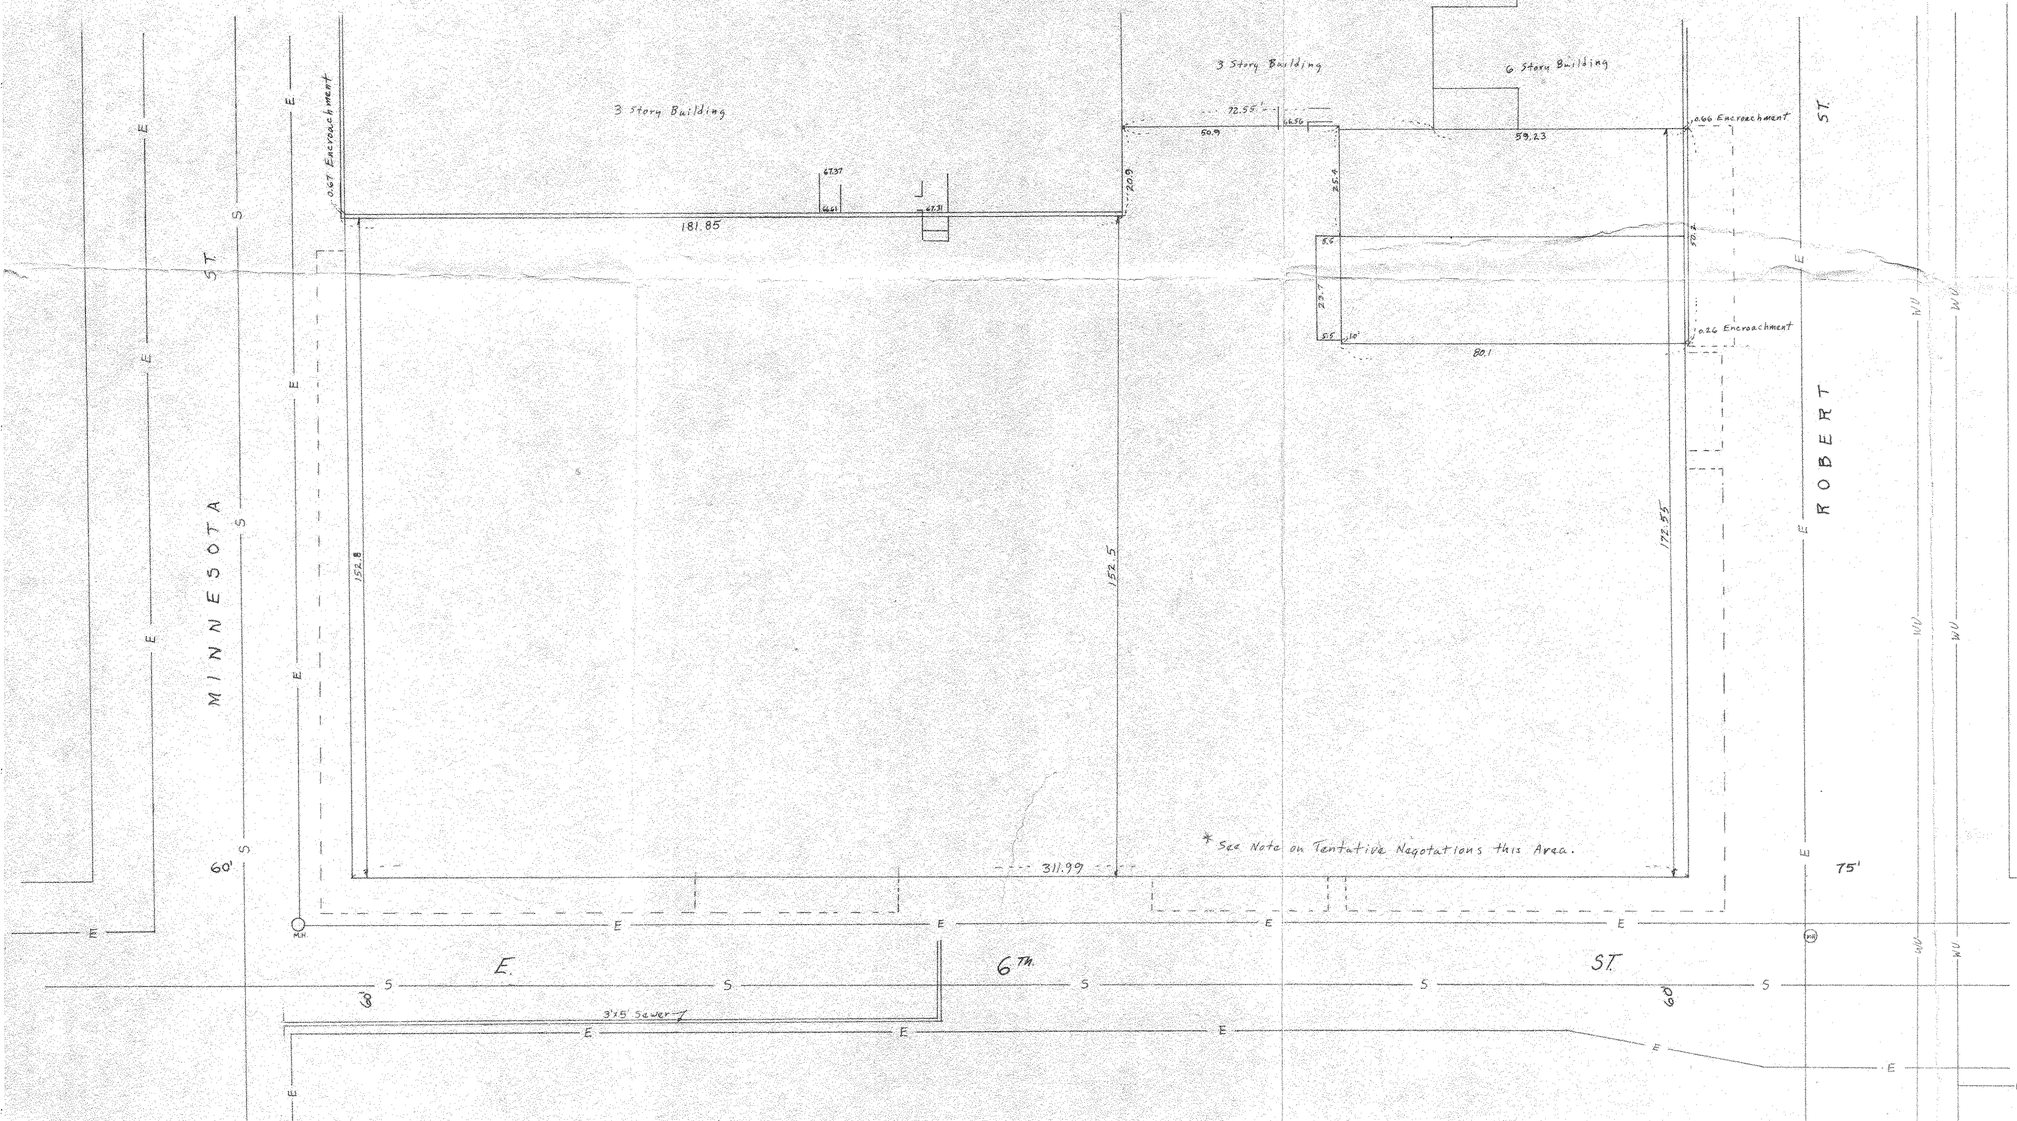

Sheet # 2 of 2

SITE MAP
AMERICAN NATIONAL BANK
BLOCK 4
CITY OF ST. PAUL, MINN.

SCALE 1" = 20'

Charles O. Georgi Company
Civil Engineering & Land Surveying
2215 W. Co. Rd. B, St. Paul 13, Minn.

January 1969

195-A