Certificate of Survey

From the office of

GEORGI- SCHMIDT & ASSOC. INC.

3092 No. Lexington Ave., Roseville, Mn. 55113

LAND SURVEYING

483-4408

I Hereby Certify that this plat shows a survey made by me of the property described on this plat, ~~and that the corners are correctly placed as shown,~~ and that all locations have been correctly shown.

Job Number: 850

Surveyed For Housing Authority

Date February 5 1981

Scale 1" = 10'

By Donald W. Schmidt
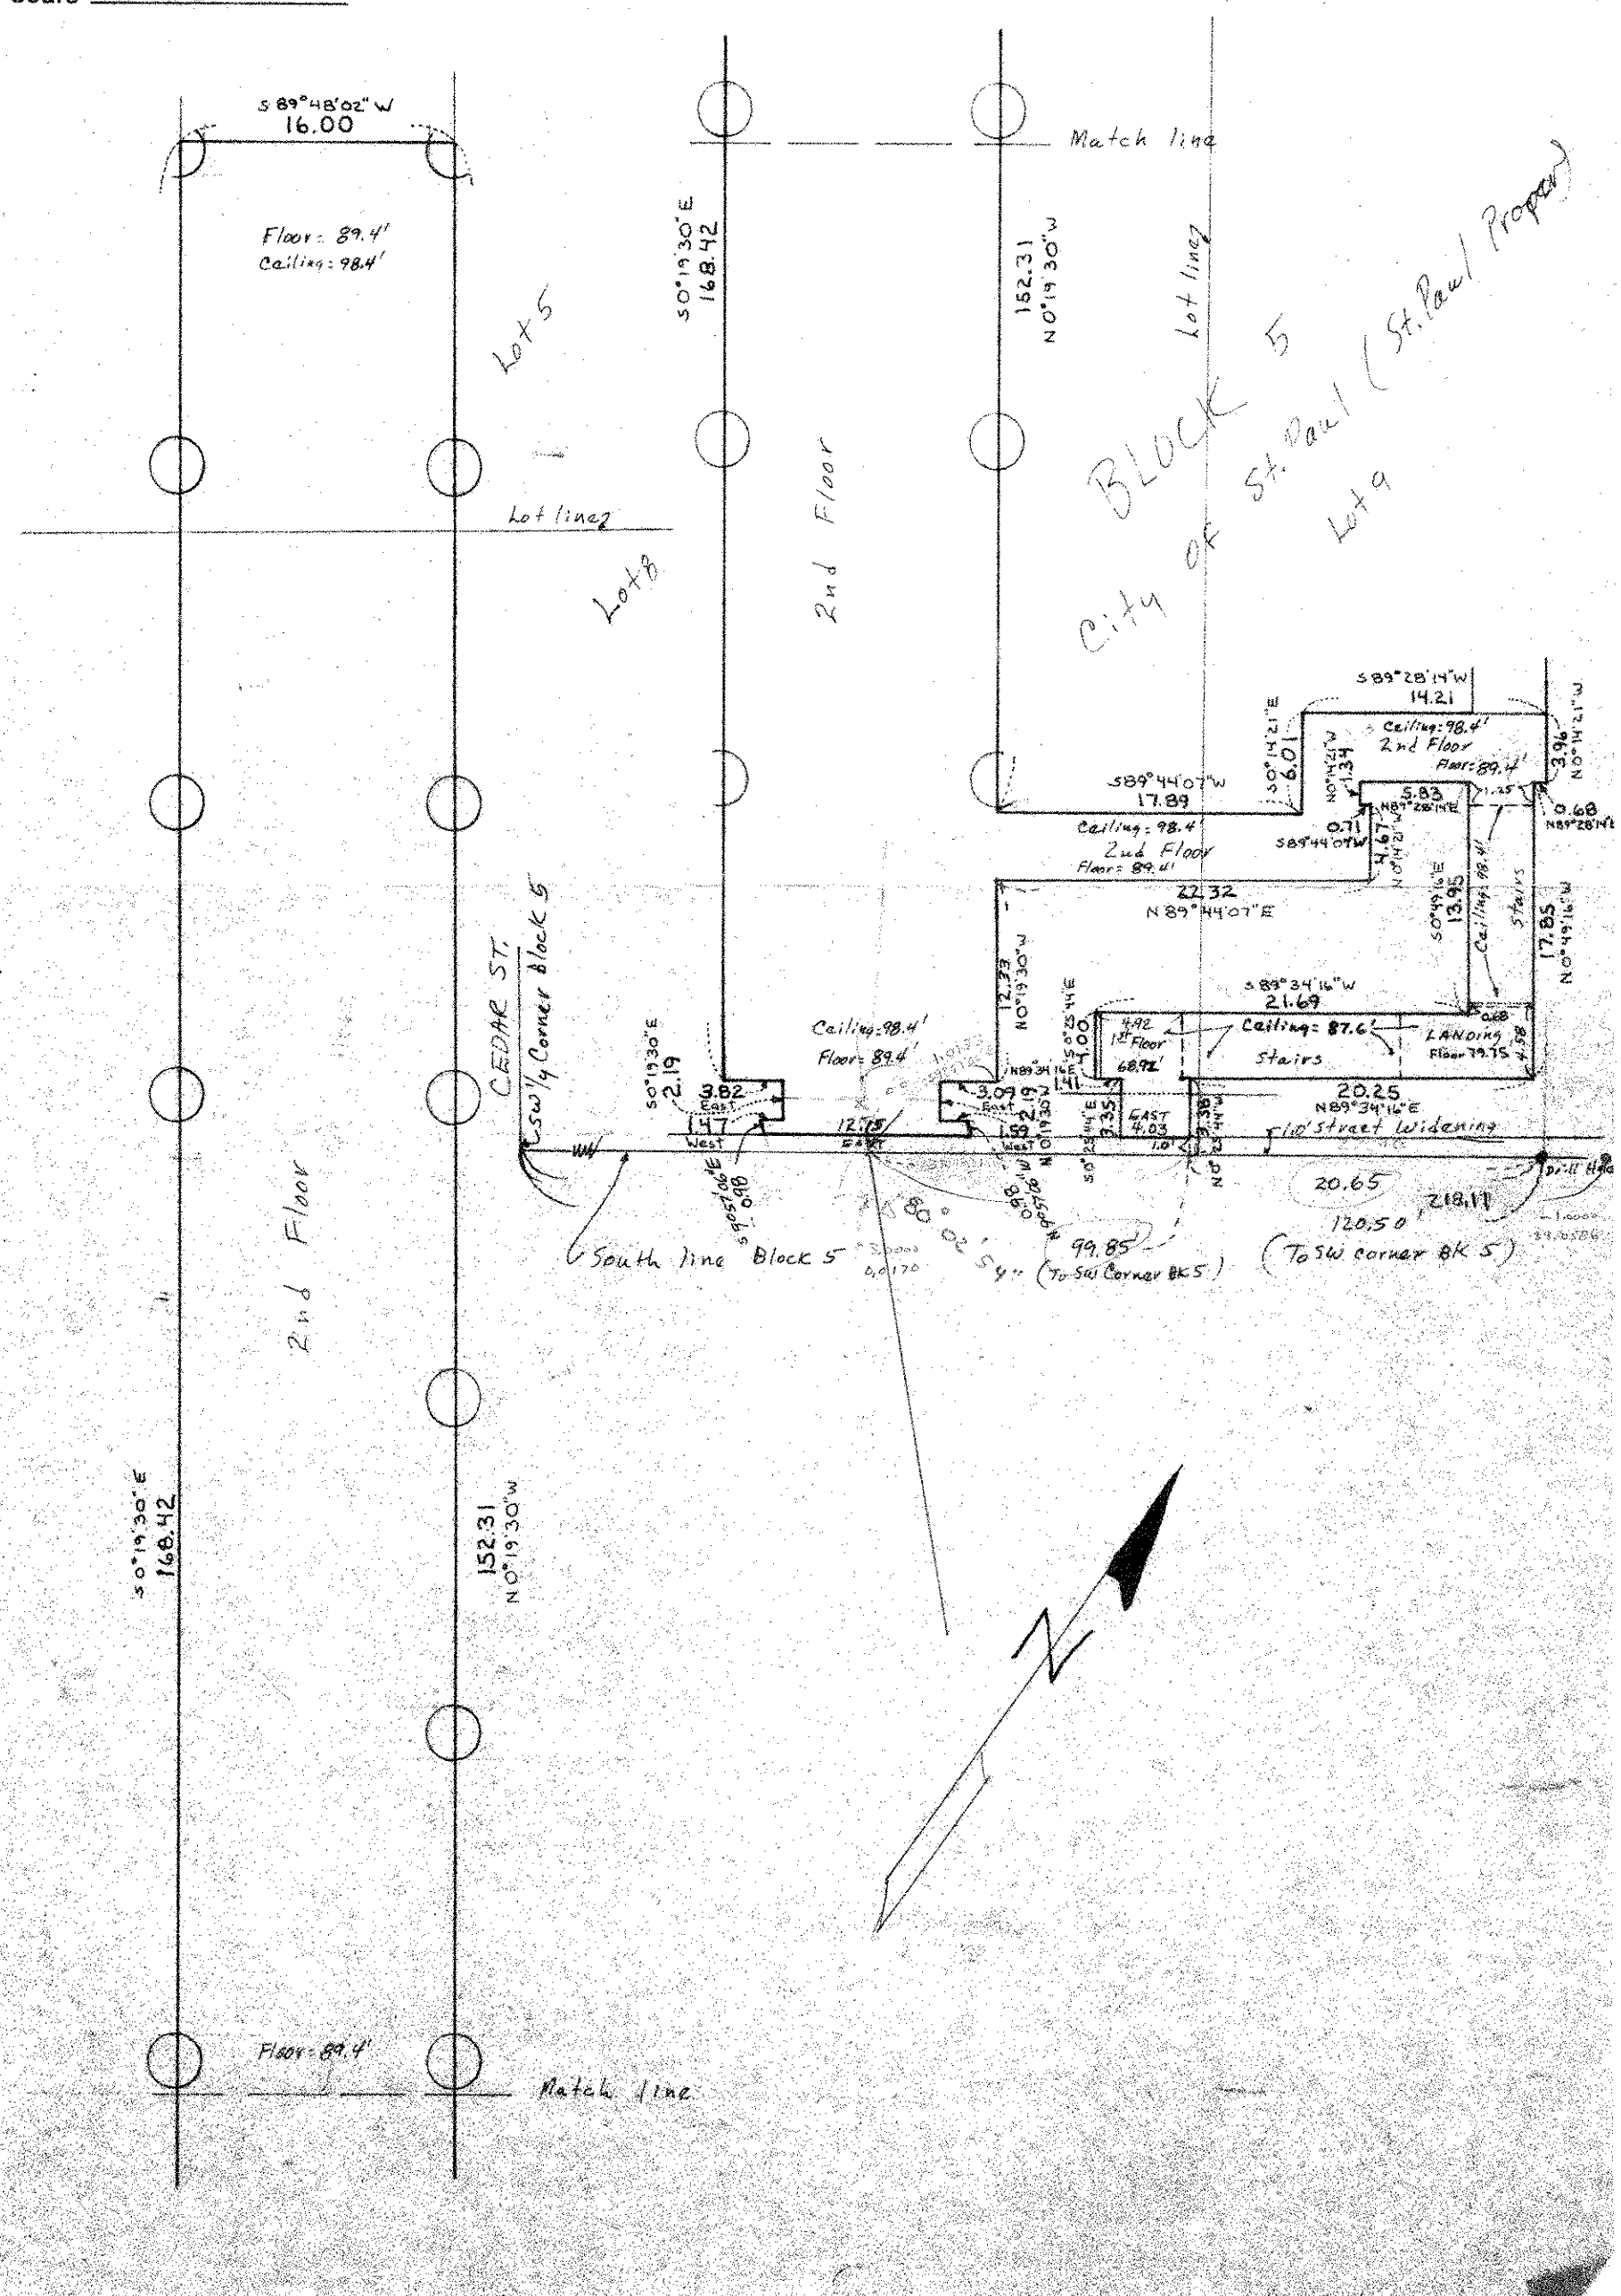
REGISTERED LAND SURVEYOR.