

NORTHERLY 1/3 of LOTS 11 & 12 BLOCK 5.

EXCEPT ALLEY

ST. PAUL PROPER,


JOHN B. IRVINE SURVEYOR.

416 GLOBE BLDG.

ST. PAUL MINN.

SCALE 10ft per inch.

MCH 8-1907.

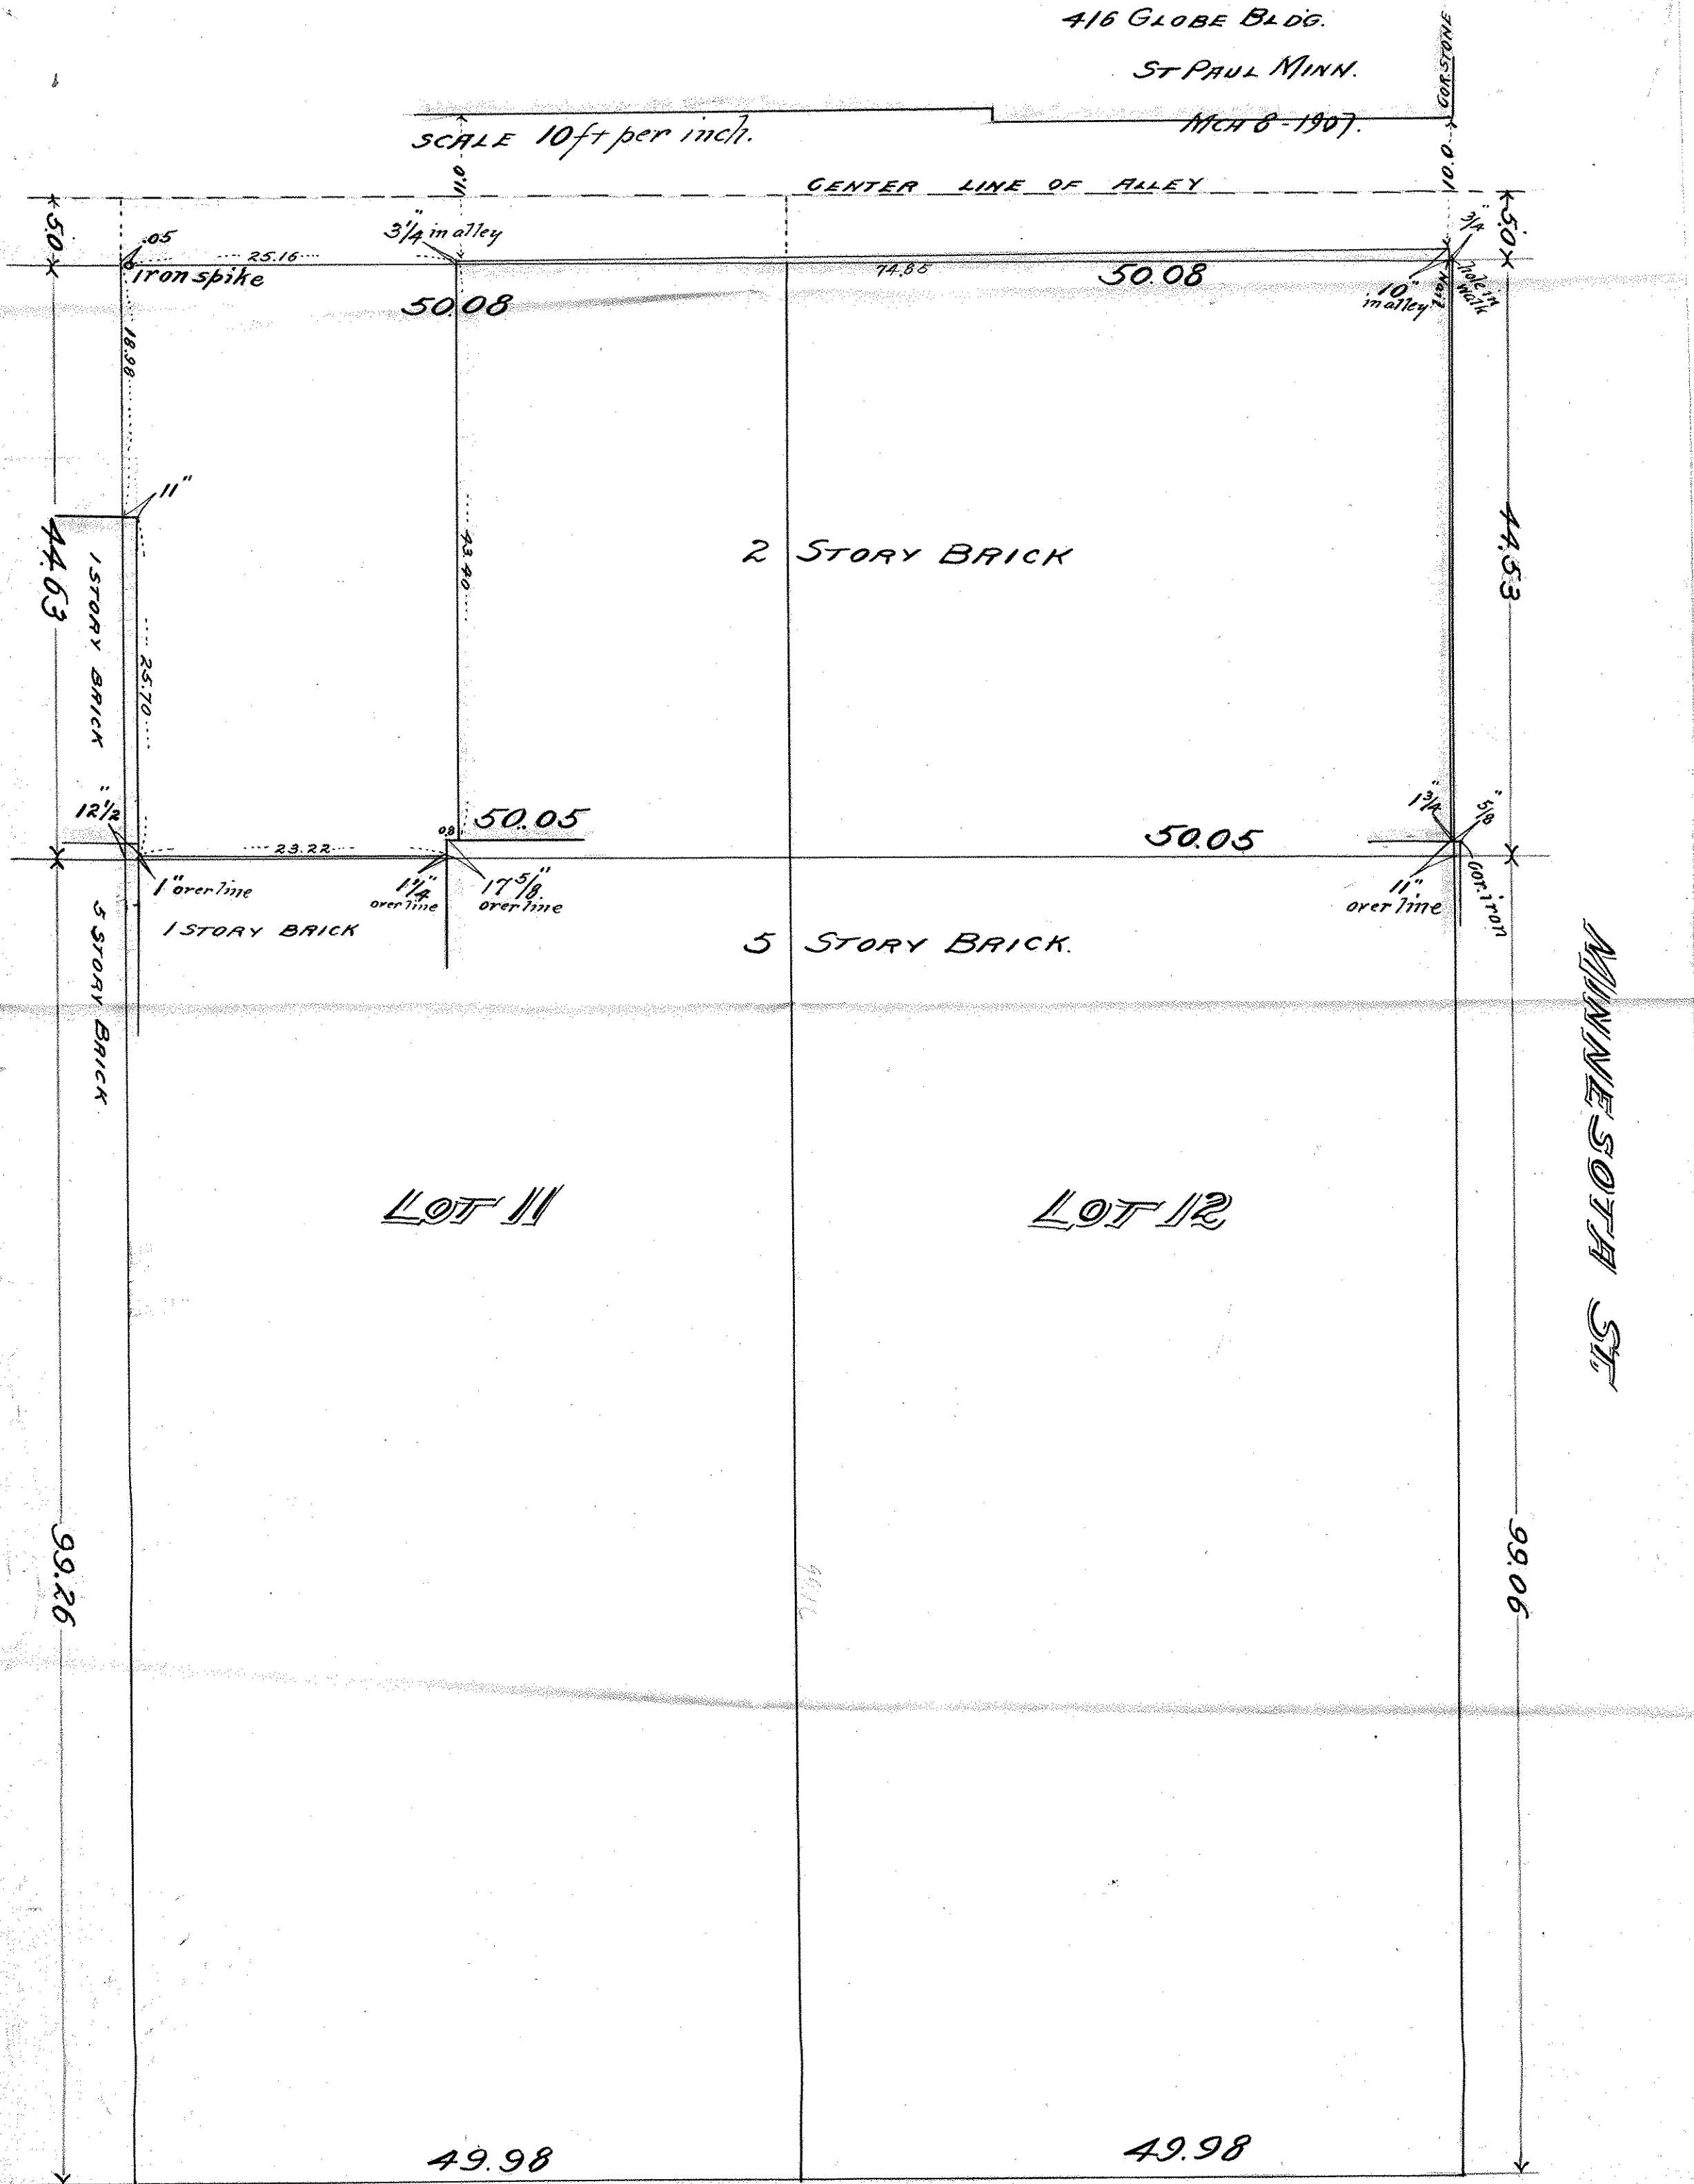

LOT 11

LOT 12

MINNESOTA ST

E. SIXTH ST