


SURVEY OF THE N'LY. LINE OF
S. 25. FT. OF THE N. 100. FT. OF LOTS 1, 2 & 3
BLK. 7, ST. PAUL PROPER

for M. Goldman

Nov. 24th 1902

20 ft. pr. inch.

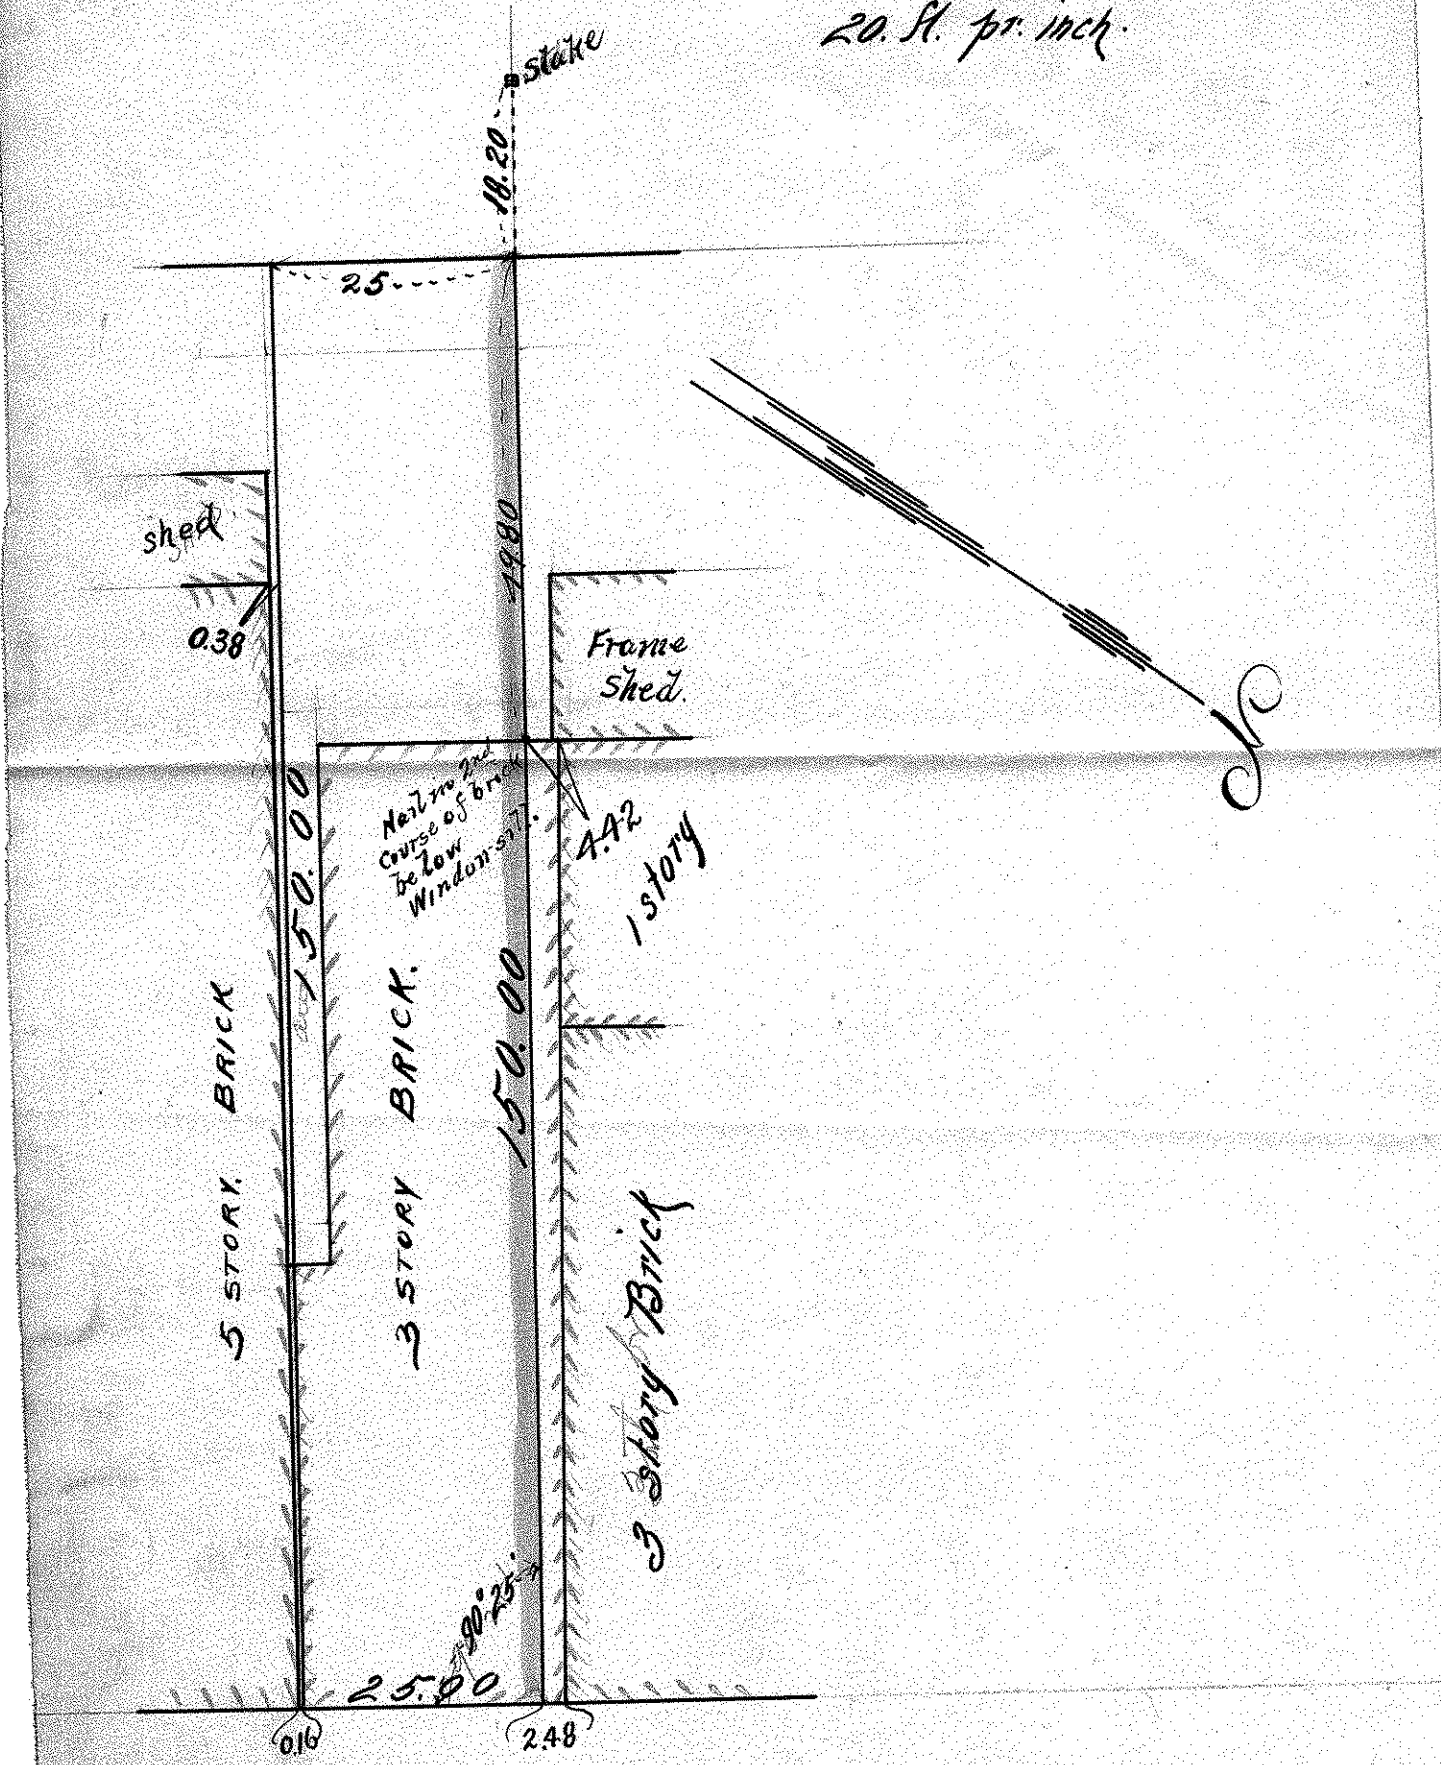

WABASHA ST.

B53 P. 33