

SOUTH 1/2 OF LOT 2 BLK. 9.

ST. PAUL PROPER.


JOHN B. IRVINE, SURVEYOR.

ROOM 508 GLOBE BLDG

ST. PAUL, MINN.

APRIL 4-05.

SCALE 10' = 1"

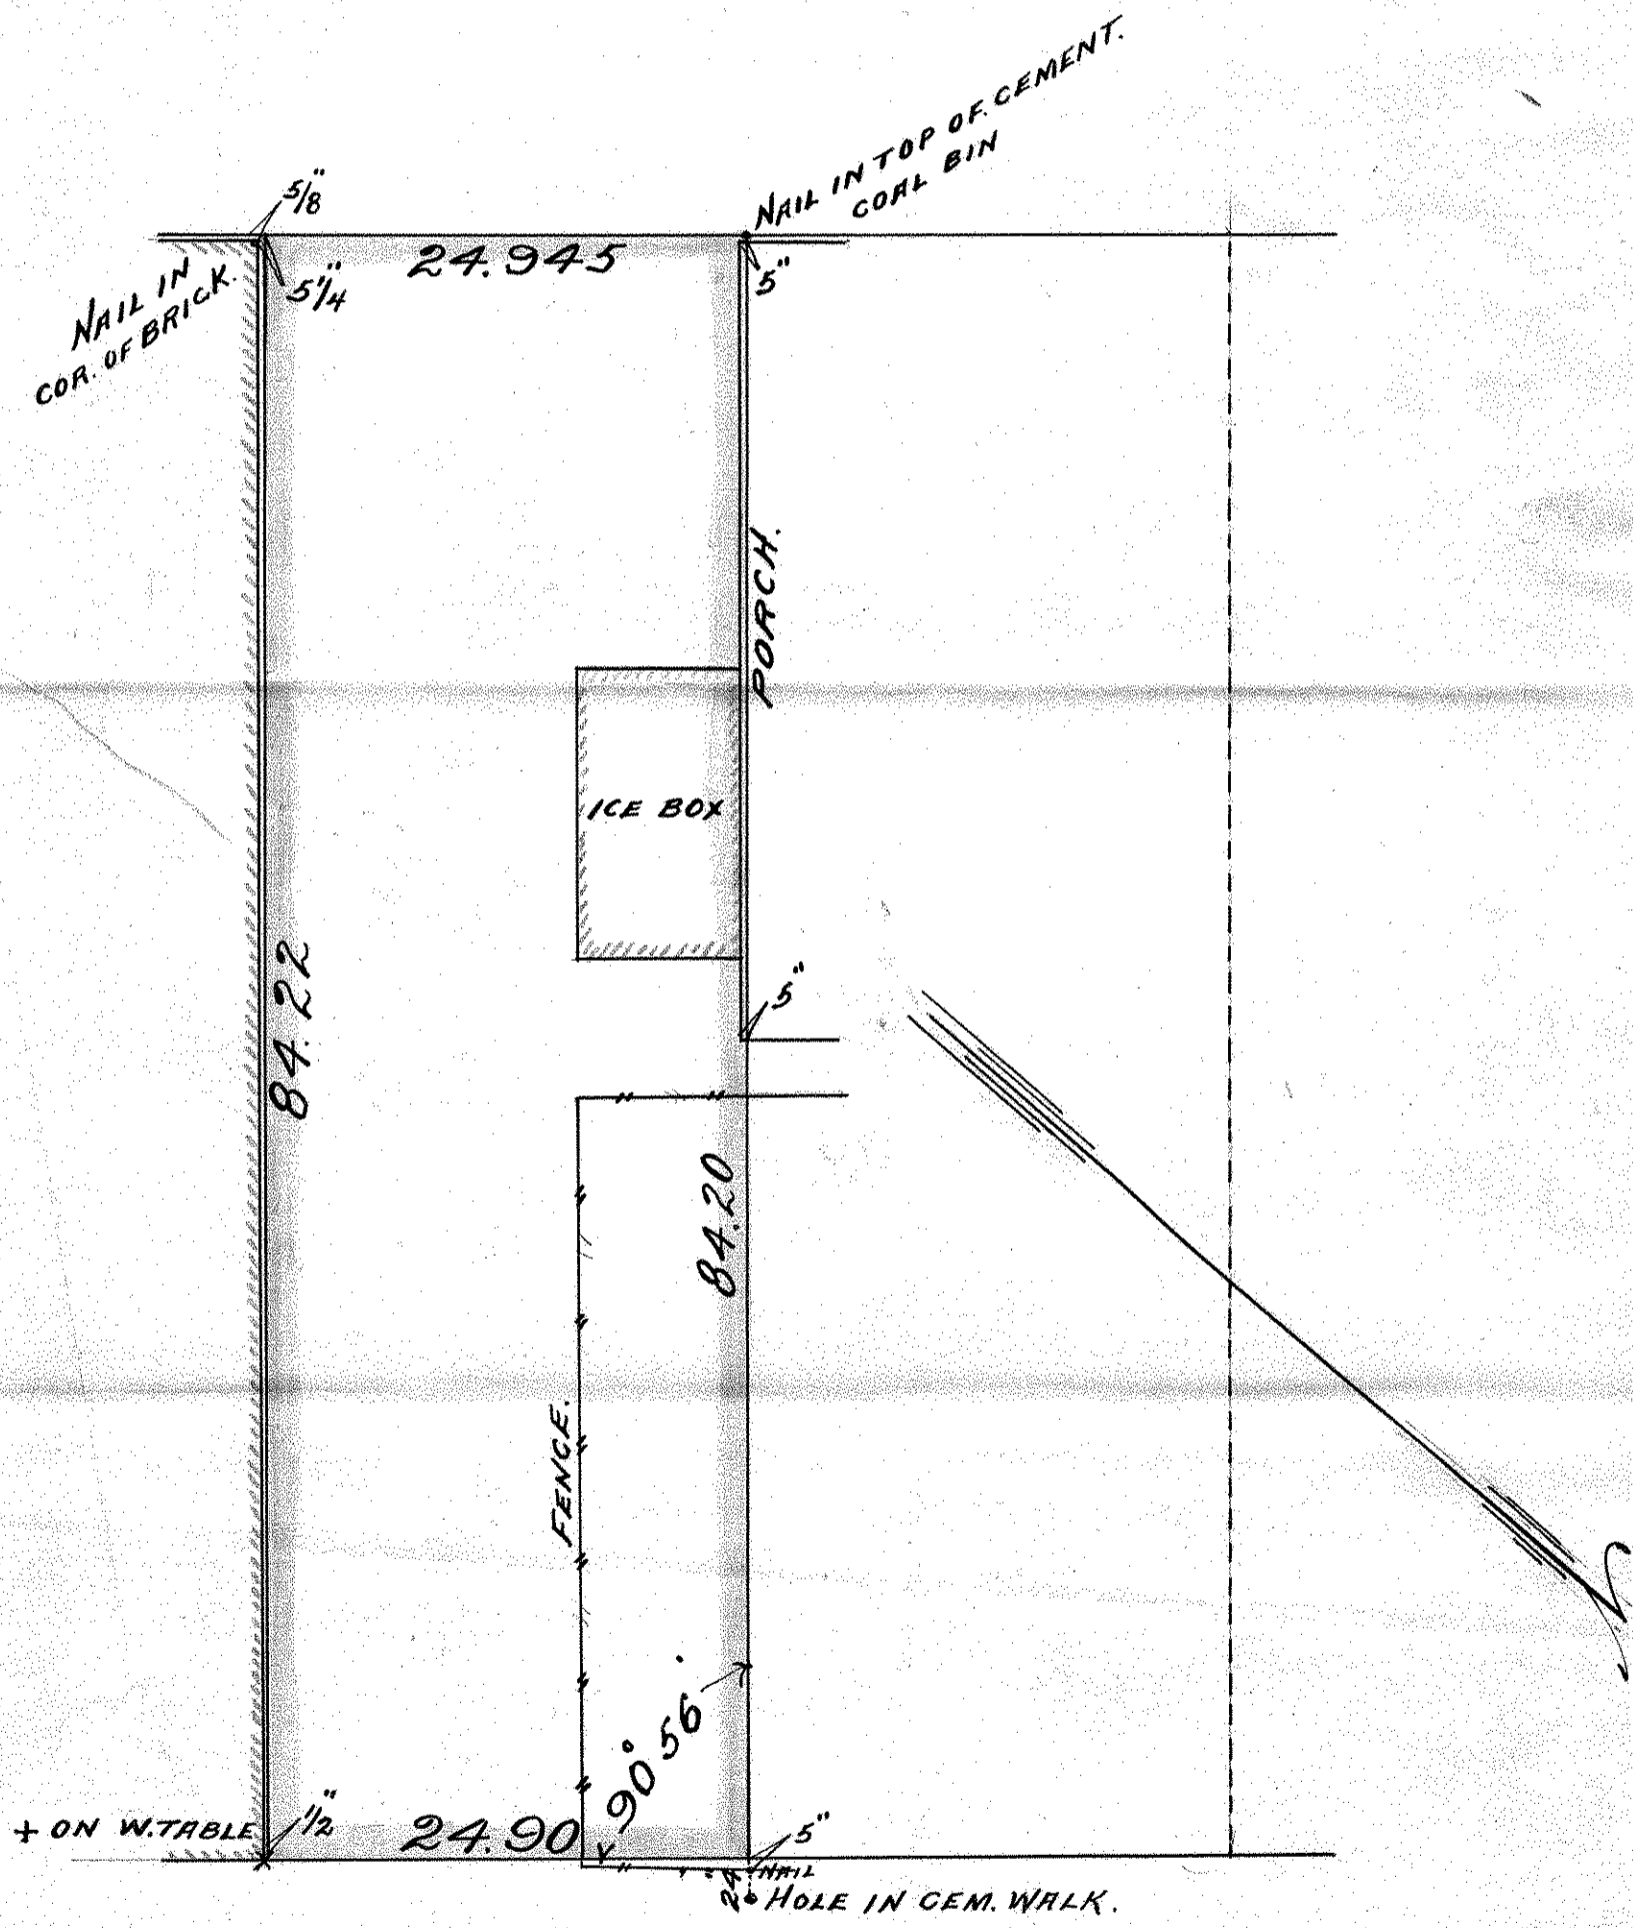

GEDAR ST.