

# CHARLES O. GEORGI COMPANY

2215 West County Road B

Saint Paul, Minnesota 55113

REGISTERED CIVIL ENGINEER AND LAND SURVEYOR

# Certificate of Survey


I Hereby Certify that this plat shows a survey made by me of the property described on this plat, and that the corners are correctly placed as shown, and that all locations have been correctly shown.

*Charles O. Georgi*  
Registered Land Surveyor No. 3360  
2/20/74 Added entrance door easement description

NORTHERN FEDERAL SAVING  
Surveyed For and LOAN ASSOCIATION  
Date: November 9, 1973

WABASHA ST.

ST.

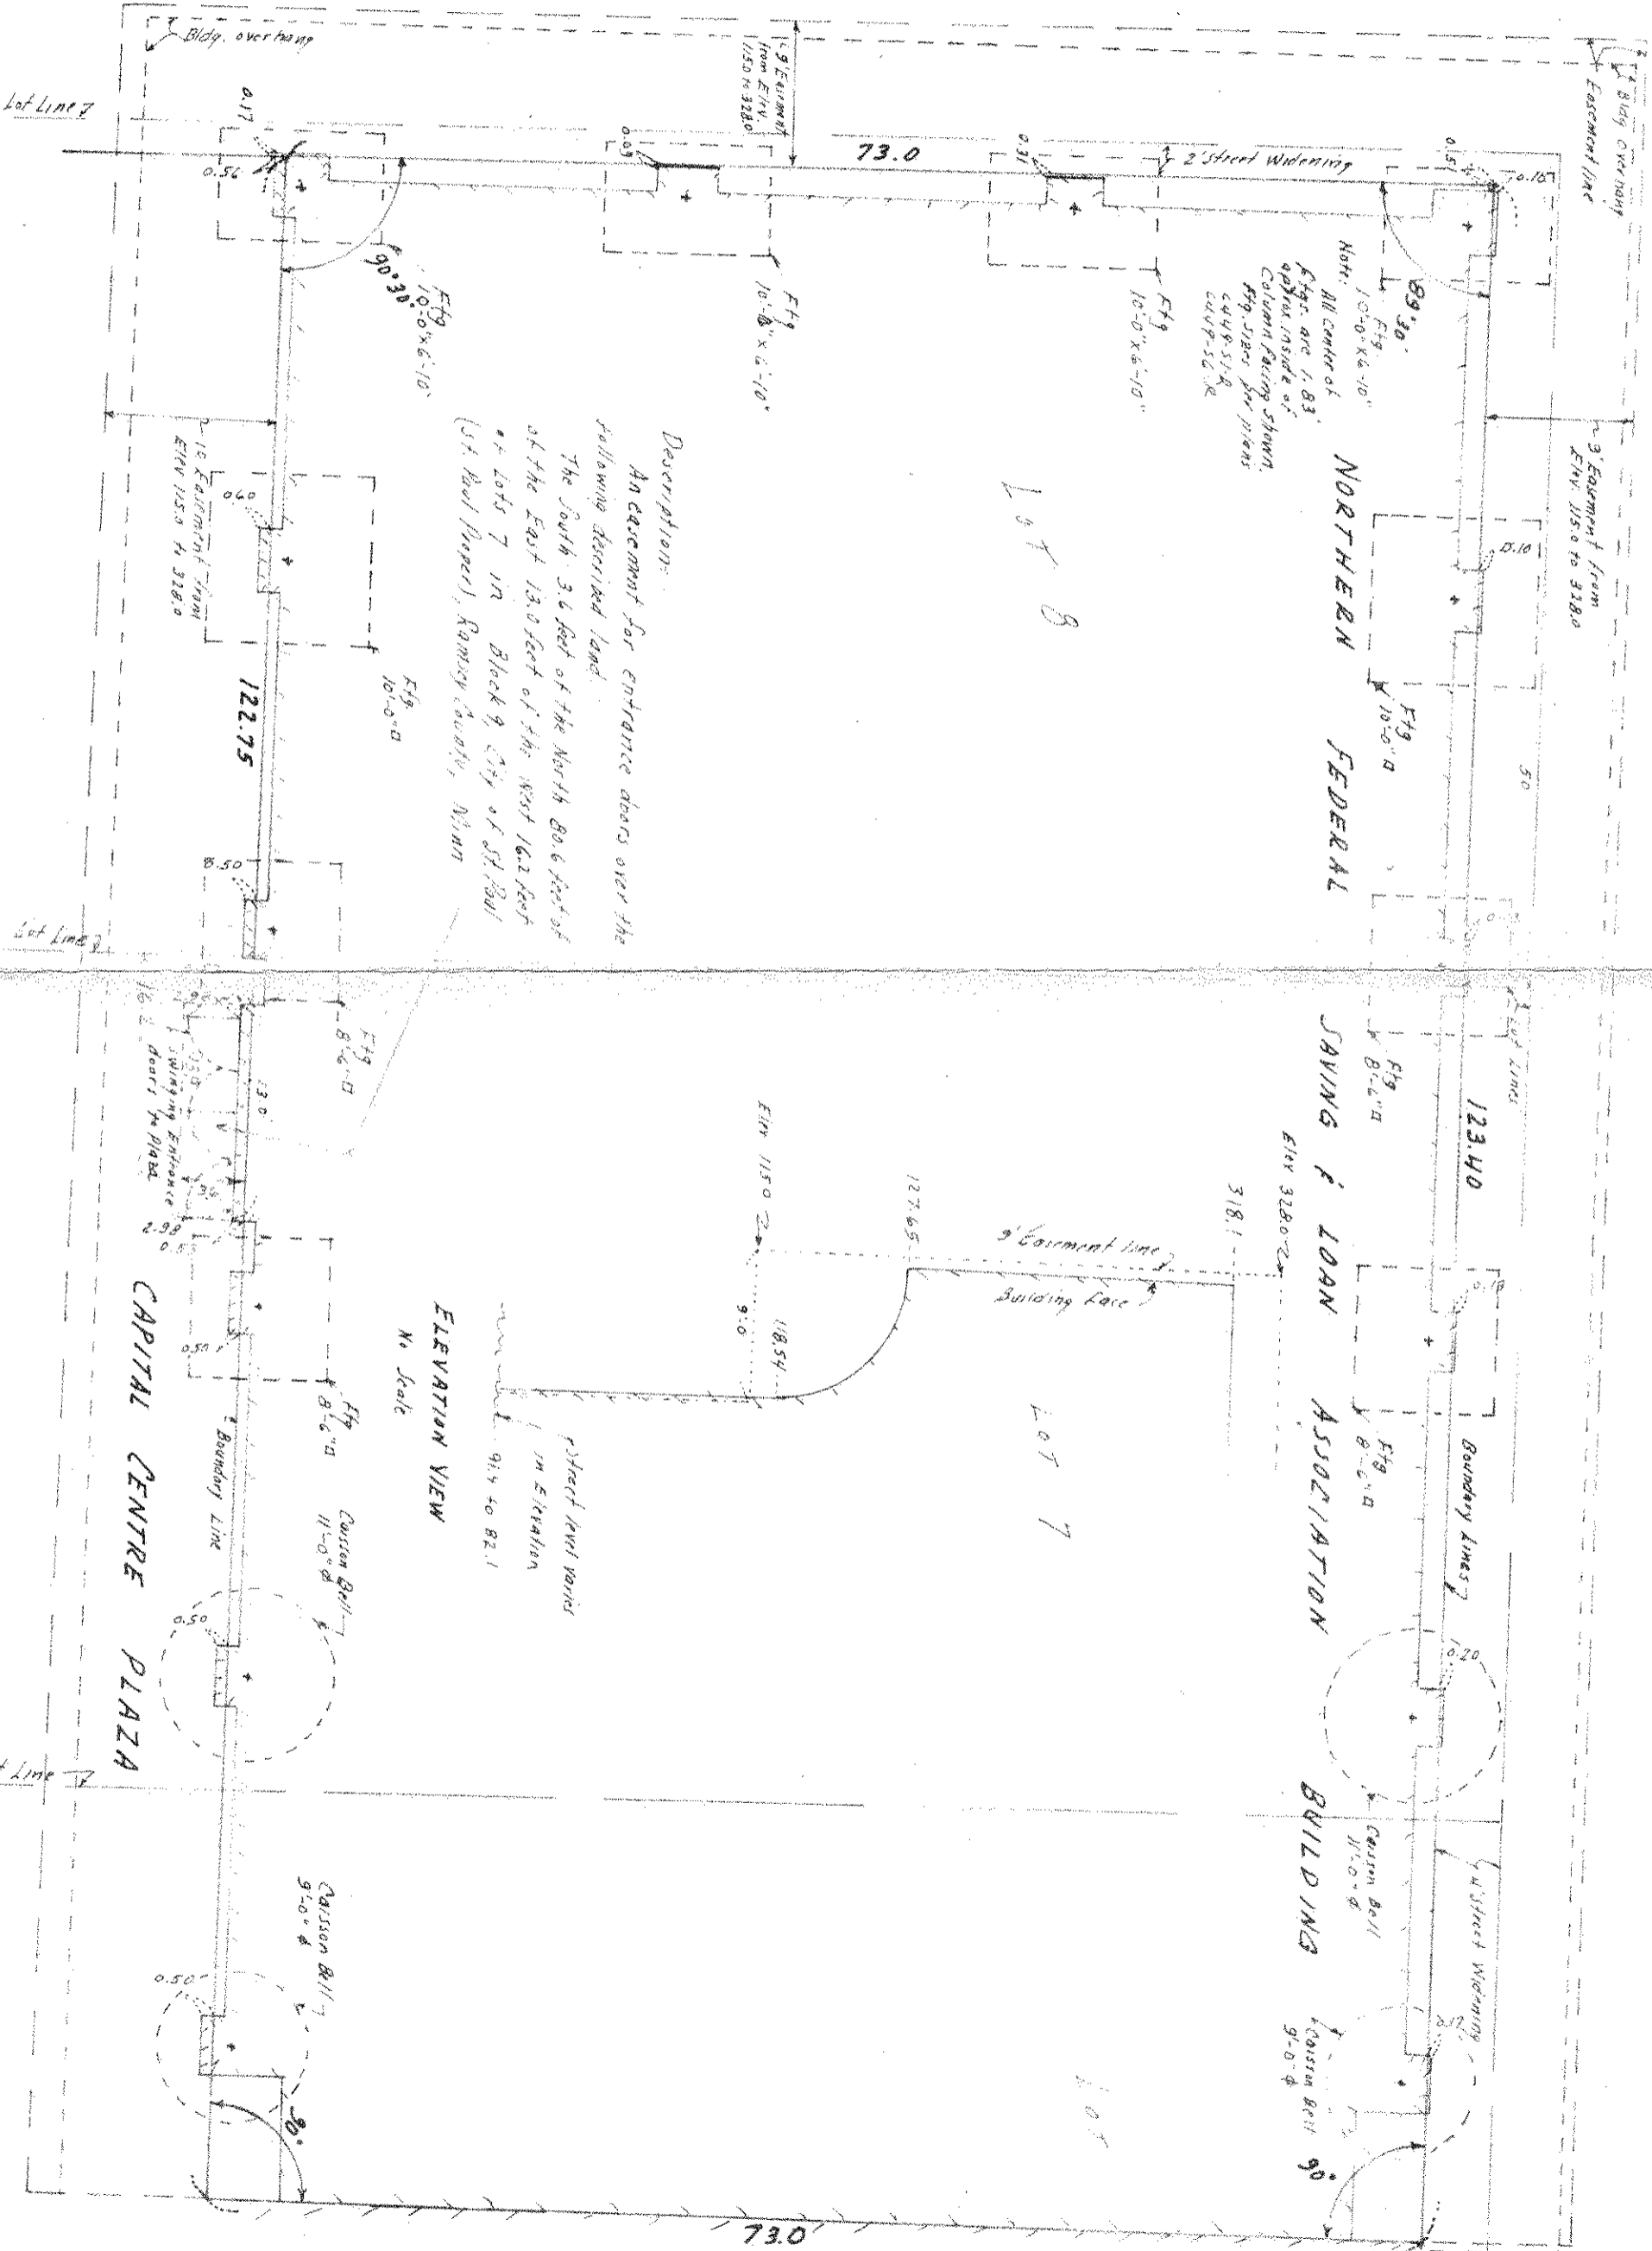

*Description:*  
An easement for entrance doors over the following described land:  
The South 3.6 feet of the North 80.6 feet of the East 130 feet of the West 16.2 feet of Lots 7 in Block 9, City of St. Paul (St. Paul Parcel), Ramsey County, Minn

*ELEVATION VIEW*  
No Scale  
Street level varies in elevation 91.4 to 82.1

*3' Easement from E.M. 1150 to 3280*  
*3' Easement from E.M. 1150 to 3280*  
*3' Easement from E.M. 1150 to 3280*

EAST

SOUTH

ST.

SCALE 1"=10'