FROM THE OFFICE OF

CHARLES O. GEORGI COMPANY

2215 West County Road B — Saint Paul 8, Minnesota

MINNESOTA REGISTERED LAND SURVEYOR

Certificate of Survey

I Hereby Certify that this plat shows a survey made by me of the property described on this plat, and that the corners are correctly placed as shown, and that all locations, encroachments, etc., have been correctly shown. drill holes were placed at 1.0 feet offset from block corners.

Revised 4/26/68

Surveyed For Housing Authority

Date February 1968

Scale 1" = 50'

By Charles O. Georgi

REGISTERED LAND SURVEYOR

Description: (Northerly Parcel)

All that part of Lots 6, 7, 8, 9, 10 and 11, Block 9, City of St. Paul (St Paul Proper) described as follows:

The Northerly 160.6 feet (measured at right angles) of said Block 9 lying Westerly of the following described line; beginning at a point on the Southerly line of the Northerly 160.6 feet of said Block 9 distant 207.99 feet Westerly of the East line of said Block 9, thence Northerly at right angles to said Southerly line a distance of 160.6 feet to the Northerly line of said Block 9 and there terminating.

Except therefrom the North 77 feet thereof, and except the Westerly 2 feet thereof for widening Wabasha St.

Contains 10,231 Sq. Ft. more or less.

Description: (Southerly Parcel)

All that part of Lots 9 and 10, Block 9, City of St Paul (St Paul Proper) described as follows:

Except the Northerly 160.6 feet (measured at right angles), all that part of said Block 9 lying Westerly of the following described line; beginning at the Southeast corner of said Block 9, thence Westerly along the Southerly line of said Block 9 a distance of 262.04 feet, thence Northerly by a deflection angle of 90°24' to the right a distance of 140 feet and there terminating.

Except therefrom the Southerly 2 feet thereof for widening of E. 5th St. and except the Westerly 2 feet thereof for widening Wabasha St.

Contains 9,594 Sq. ft. more or less.

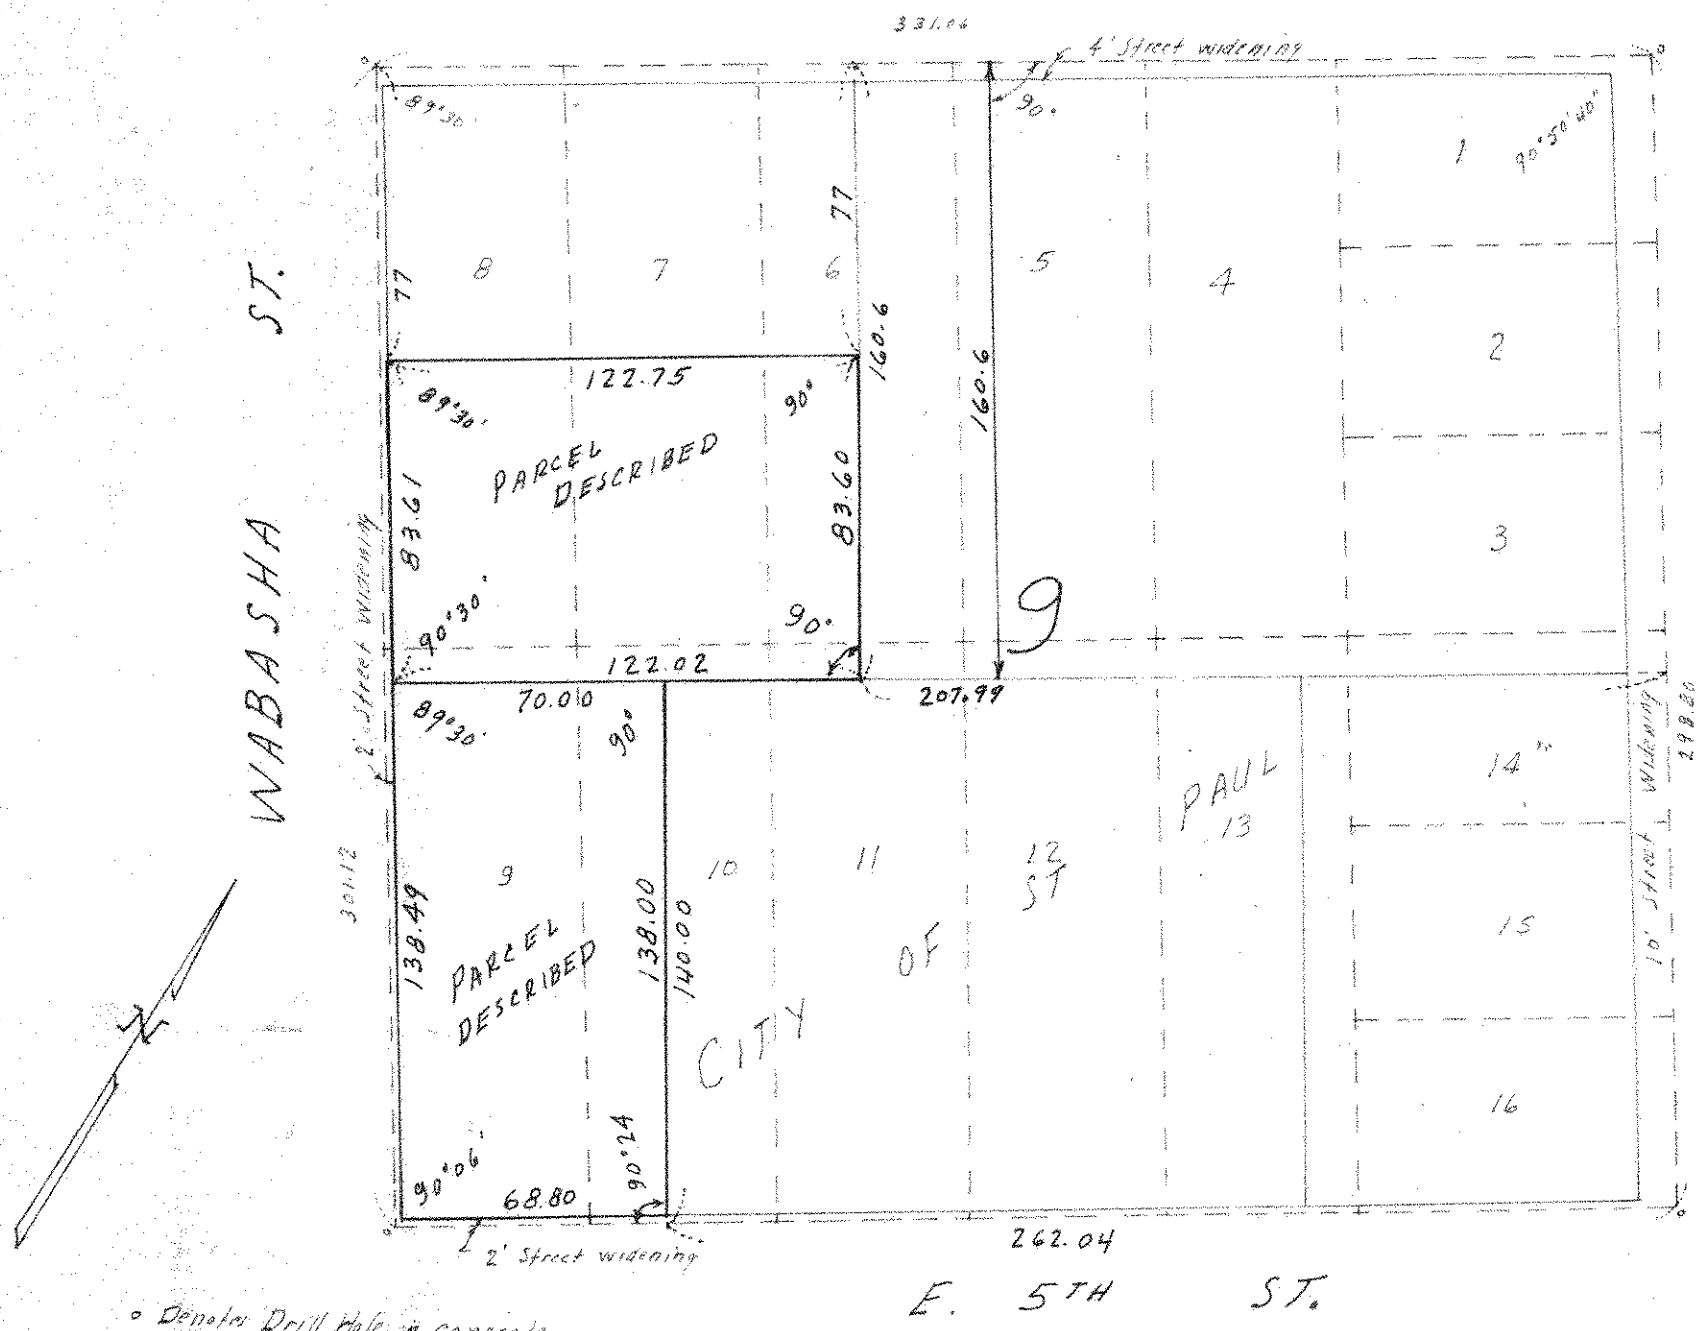

° Denotes Drill Hole in Concrete - offset 1.0' from block corner