Printed
2 - 2/22/65
6 - 5/3/65

FROM THE OFFICE OF

CHARLES O. GEORGI COMPANY

2215 West County Road B — Saint Paul 8, Minnesota

MINNESOTA REGISTERED LAND SURVEYOR

Certificate of Survey

I Hereby Certify that this plat shows a ~~survey~~ *drawing* made by me of the property described on this plat, ~~and that the corners are correctly placed as shown,~~ and that all locations, encroachments, etc., have been correctly shown.
This is not a boundary survey for parcels or lots.

Surveyed For HOUSING & REDEVELOPMENT AUTHORITY
Date February 1965
Scale 1" = 50'

By *Charles O. Georgi*
REGISTERED LAND SURVEYOR

DESCRIPTION:

All of Lots 1 thru 16, Block 9, City of St. Paul (St. Paul Proper).
Contains 99,568 sq. ft. more or less.

Parcel No.	Area (sq. ft.)
1	3 145
2	3 293
3	2 468
4	2 470
5	7 420
6	7 428
7	9 890
8	4 990
9	14 920
10	11 168
11	3 719
12	7 430
13	12 613
14	6 669
15	1 945

Surveyors Note:
Field location of the lines of occupancy were taken on block exterior only. Boundary lines are based on prorated distances from deed descriptions except parcels 7-8, 1-2 and 1,2-15 where deed gives a stated distance or building line control.
Above is subject to legal verification and party wall agreements.

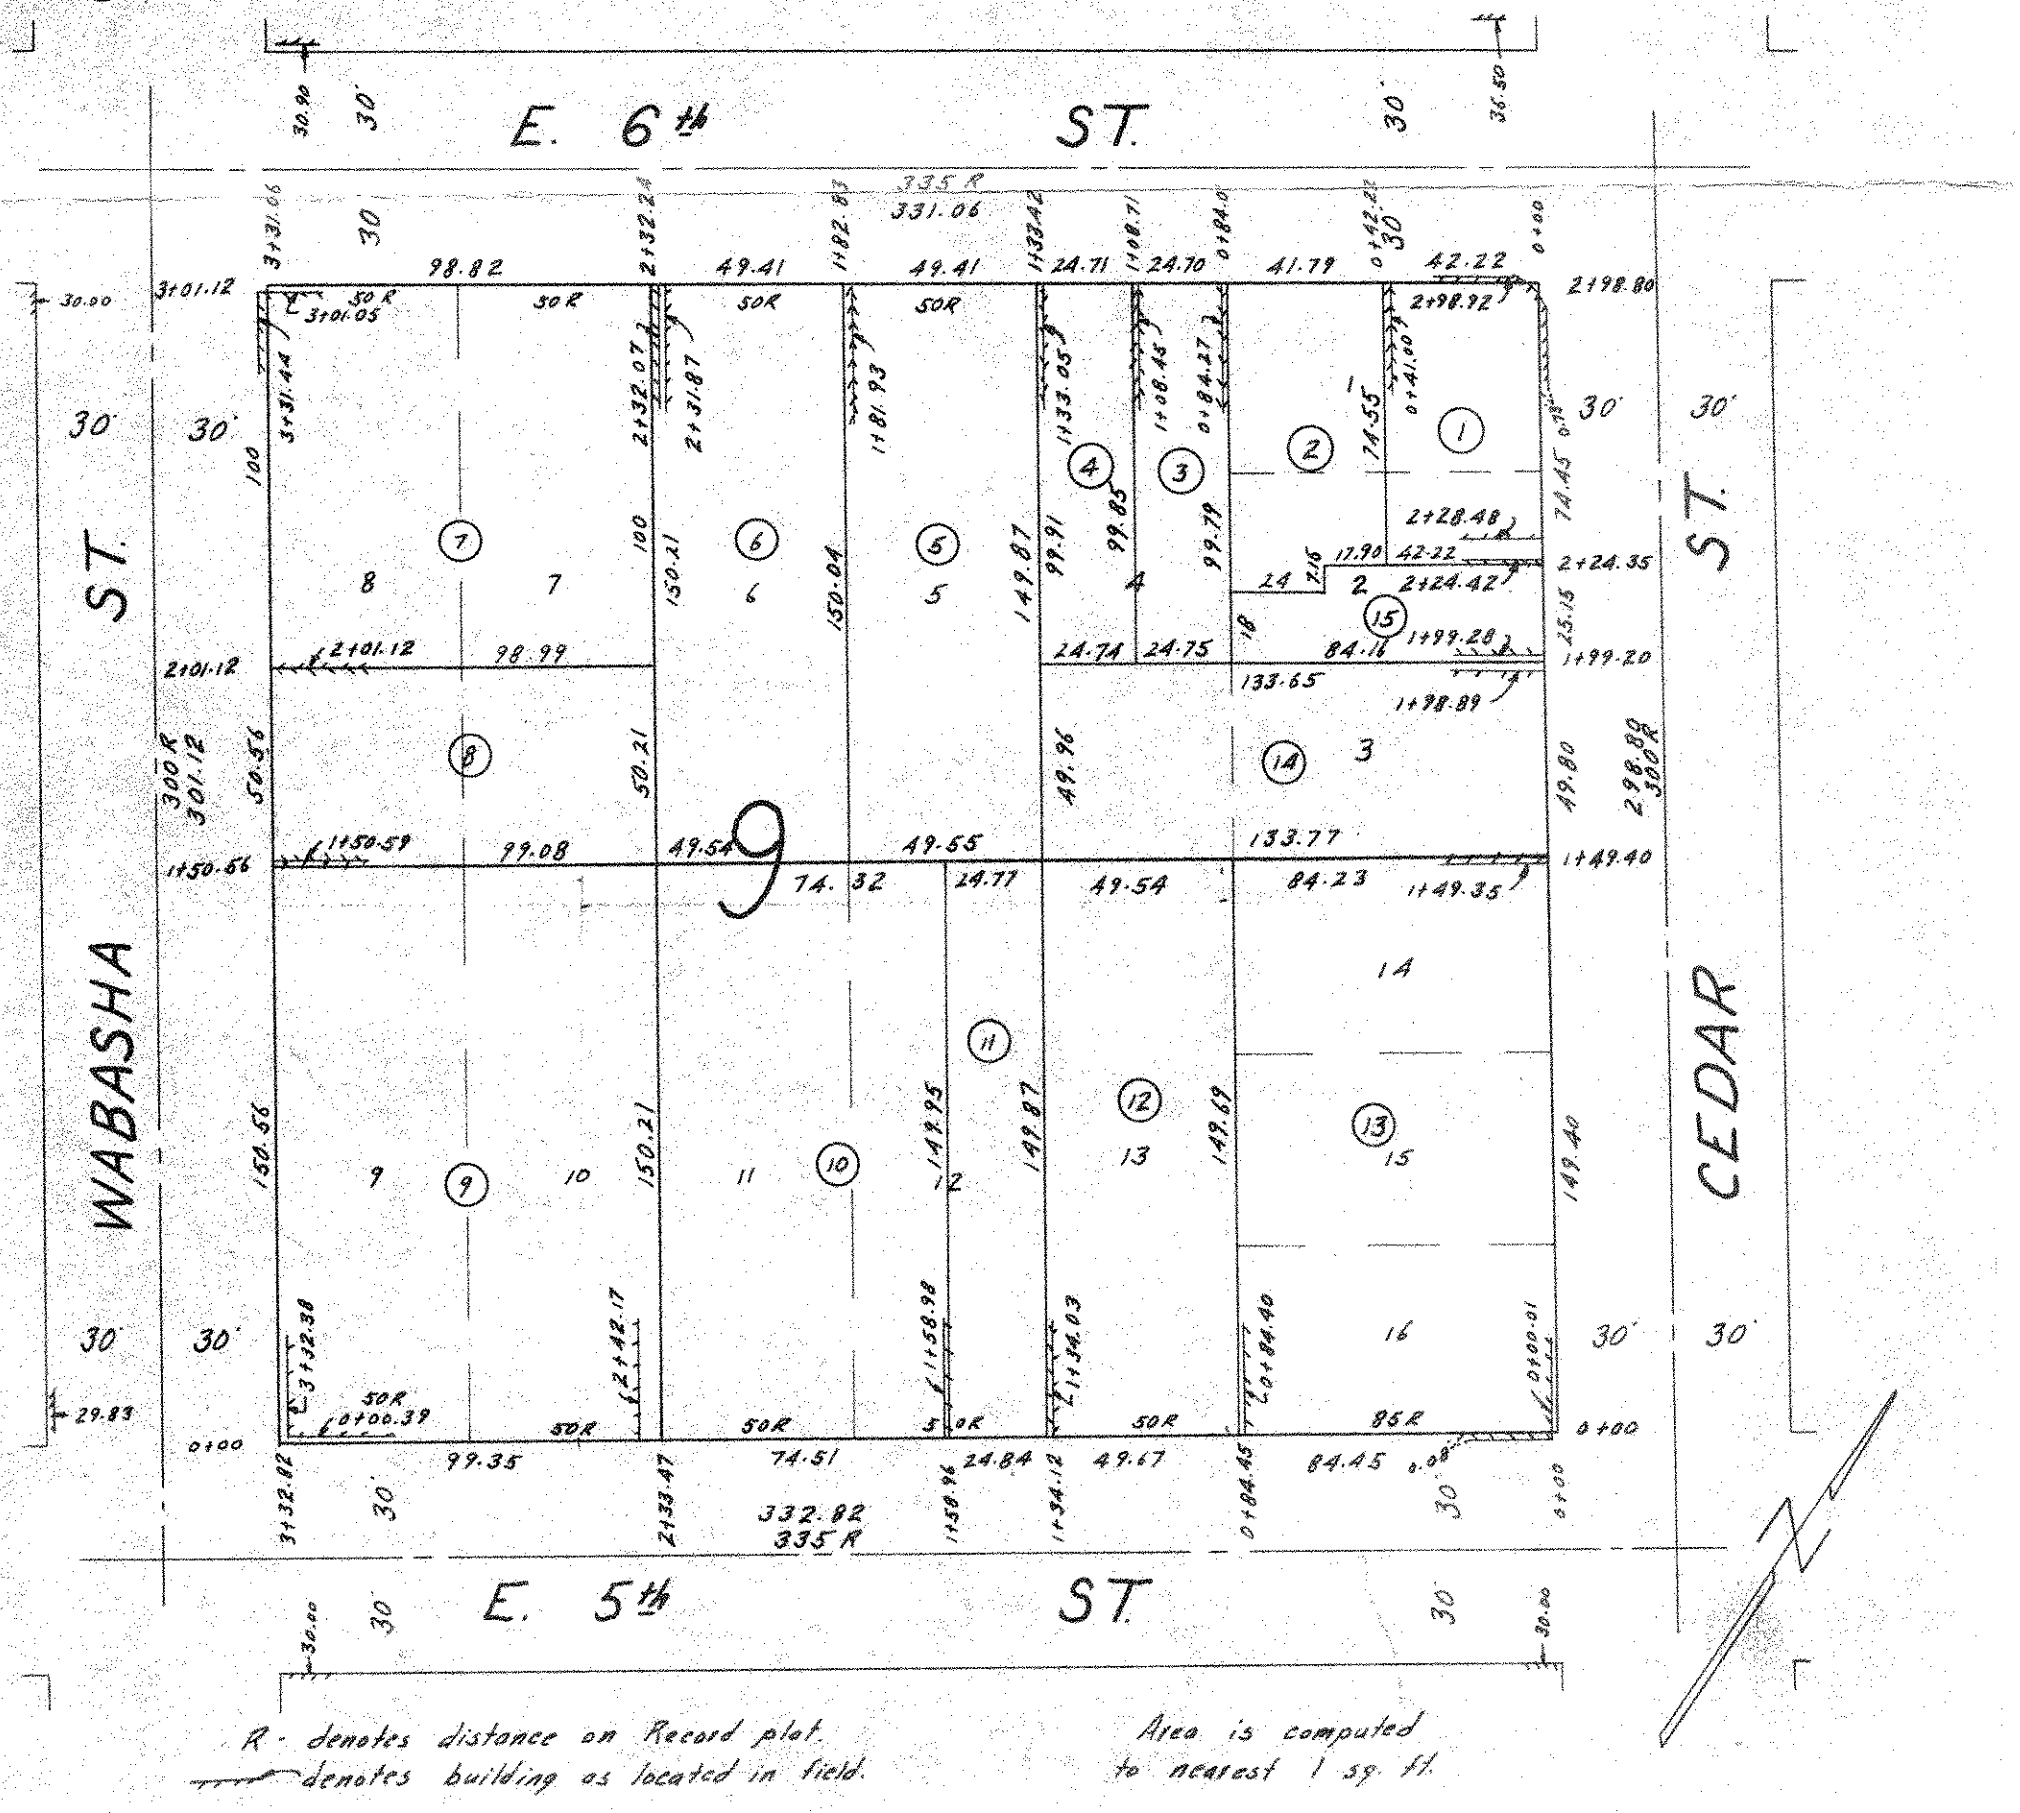

R - denotes distance on Record plat.
denotes building as located in field.

Area is computed to nearest 1 sq. ft.