Certificate of Survey

FROM THE OFFICE OF

CHARLES O. GEORGI COMPANY

2215 West County Road B — Saint Paul 8, Minnesota

MINNESOTA REGISTERED LAND SURVEYOR

I Hereby Certify that this plat shows a survey made by me of the property described on this plat, and that the corners are correctly placed as shown, and that all locations, encroachments, etc., have been correctly shown.

11/14/69 - printed
4/23/70 added reference note to skyway bldg.

Surveyed For Economic Laboratory Inc. G. Dimond - Architect

Date November 1969

Scale see dwg 1" = 20' & 1" = 10'

By Charles O. Georgi
REGISTERED LAND SURVEYOR

For description - see attached sheet.

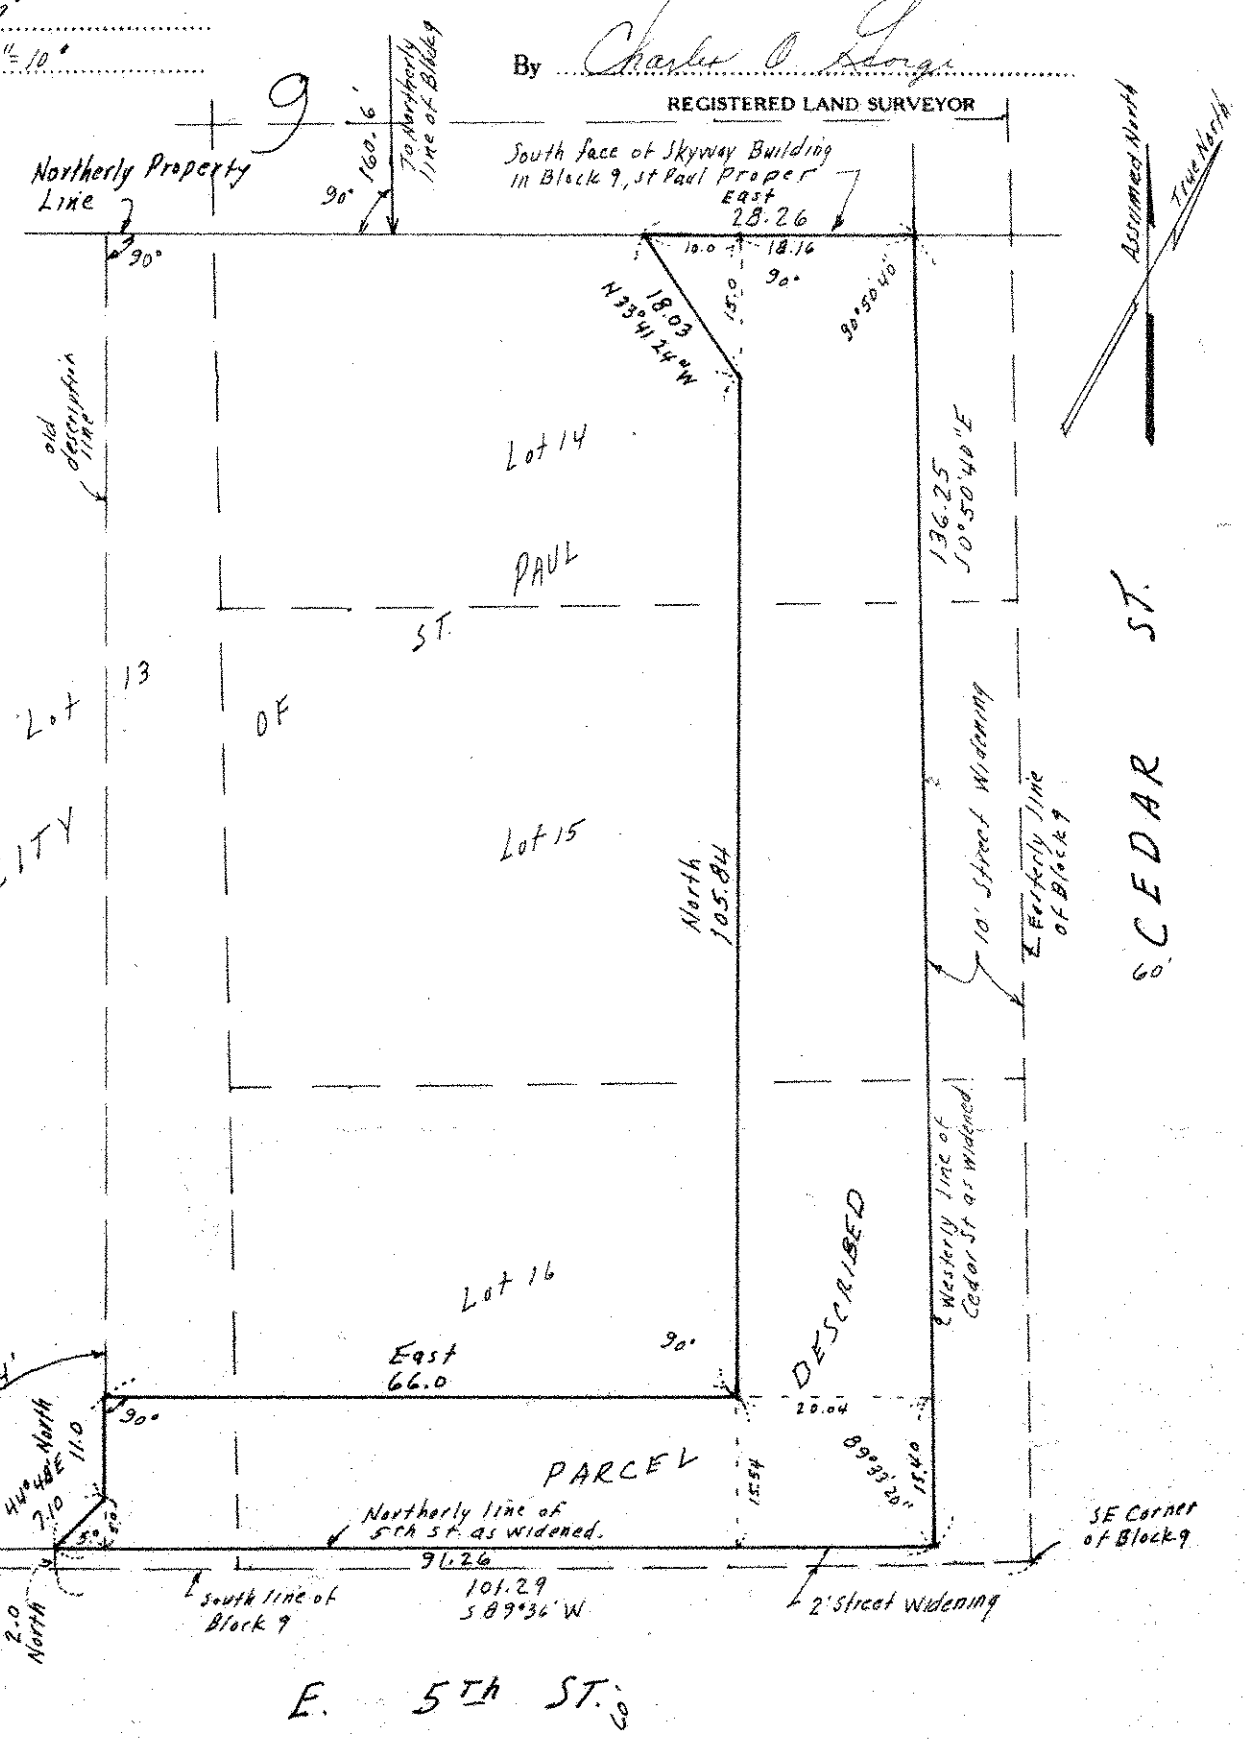

5TH St. Ingress Driveway Ramp Easement To Skyway Bldg.

SCALE 1" = 20'

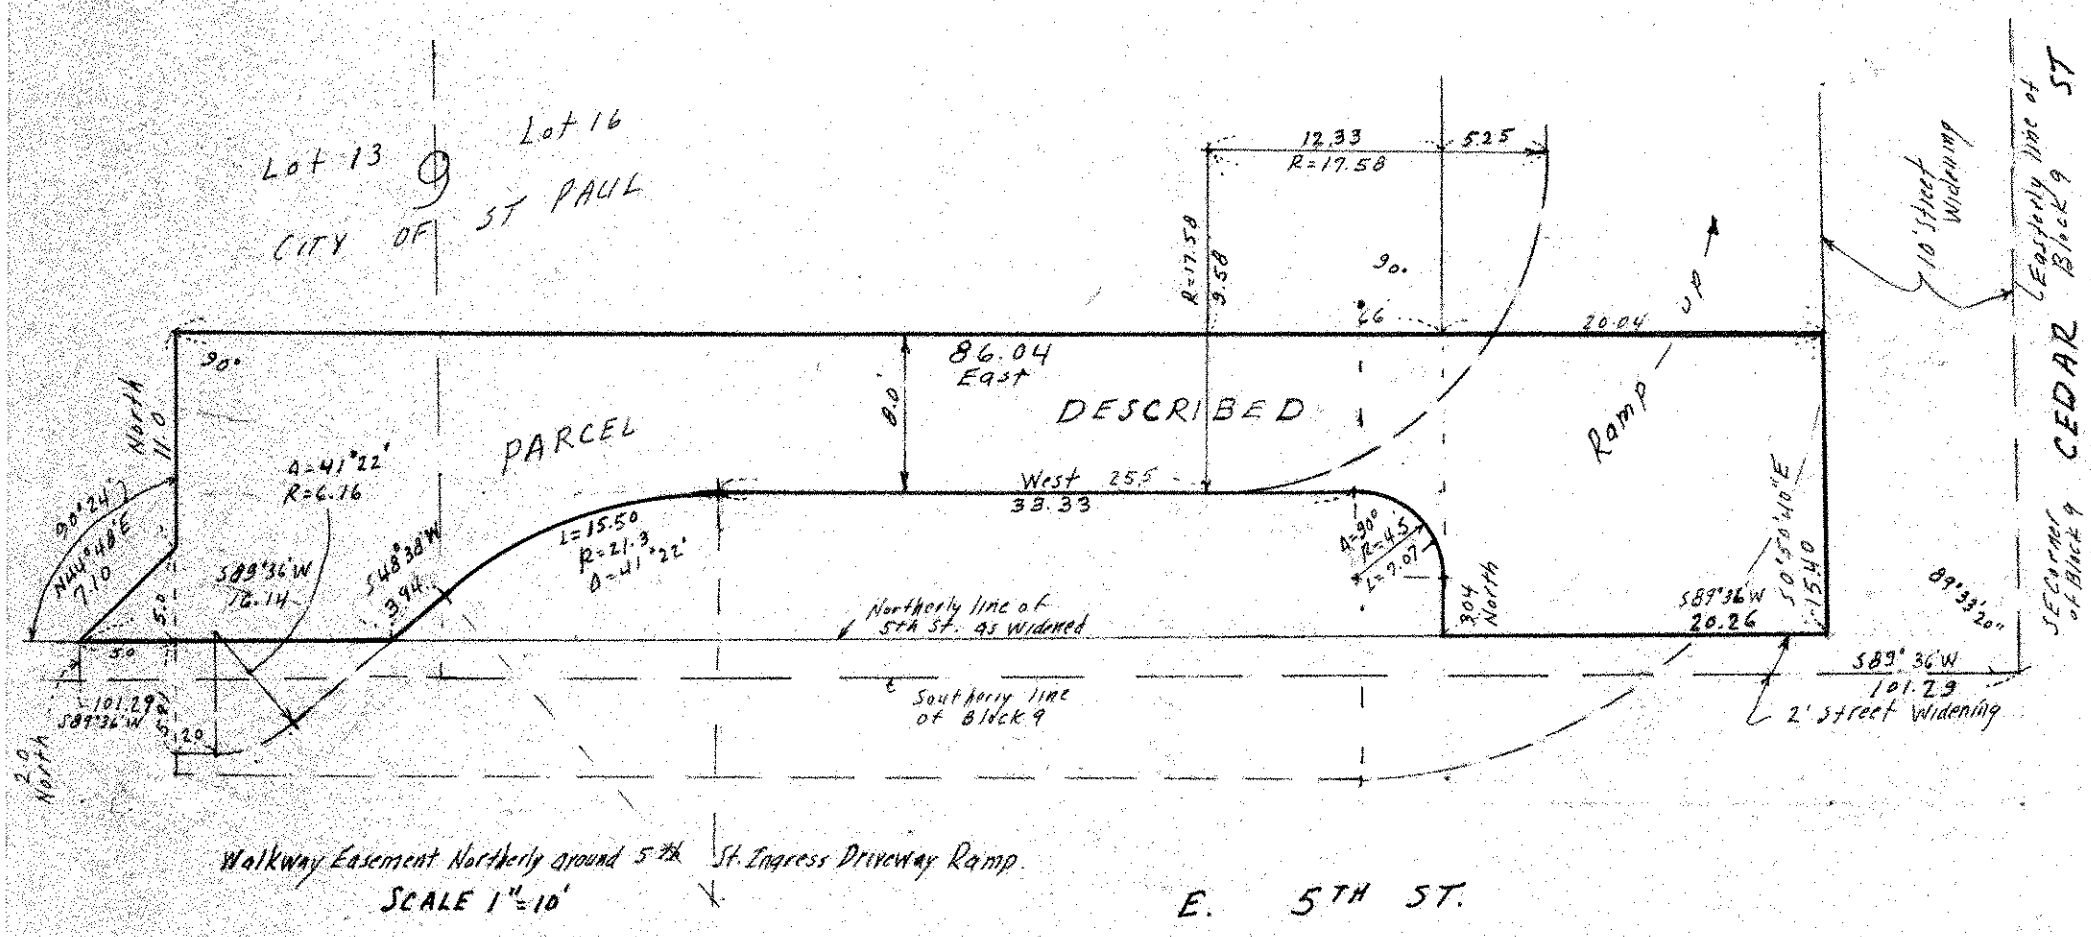

Walkway Easement Northerly around 5th St. Ingress Driveway Ramp.

SCALE 1" = 10'