NE 6 28 22

FROM THE OFFICE OF

CHARLES O. GEORGI COMPANY

2215 West County Road B Saint Paul, Minnesota 55113

REGISTERED CIVIL ENGINEER AND LAND SURVEYOR

Certificate of Survey

I Hereby Certify that this plat shows a walkway and stairway location survey made by me of the property described on this plat, ~~and that the corners are correctly placed as shown~~, and that all locations have been correctly shown.

Sep 23 2 PRINTS to RANCONE

By Charles O. Georgi
REGISTERED LAND SURVEYOR

Eugene A. Rancone

Surveyed For Northern Federal Building
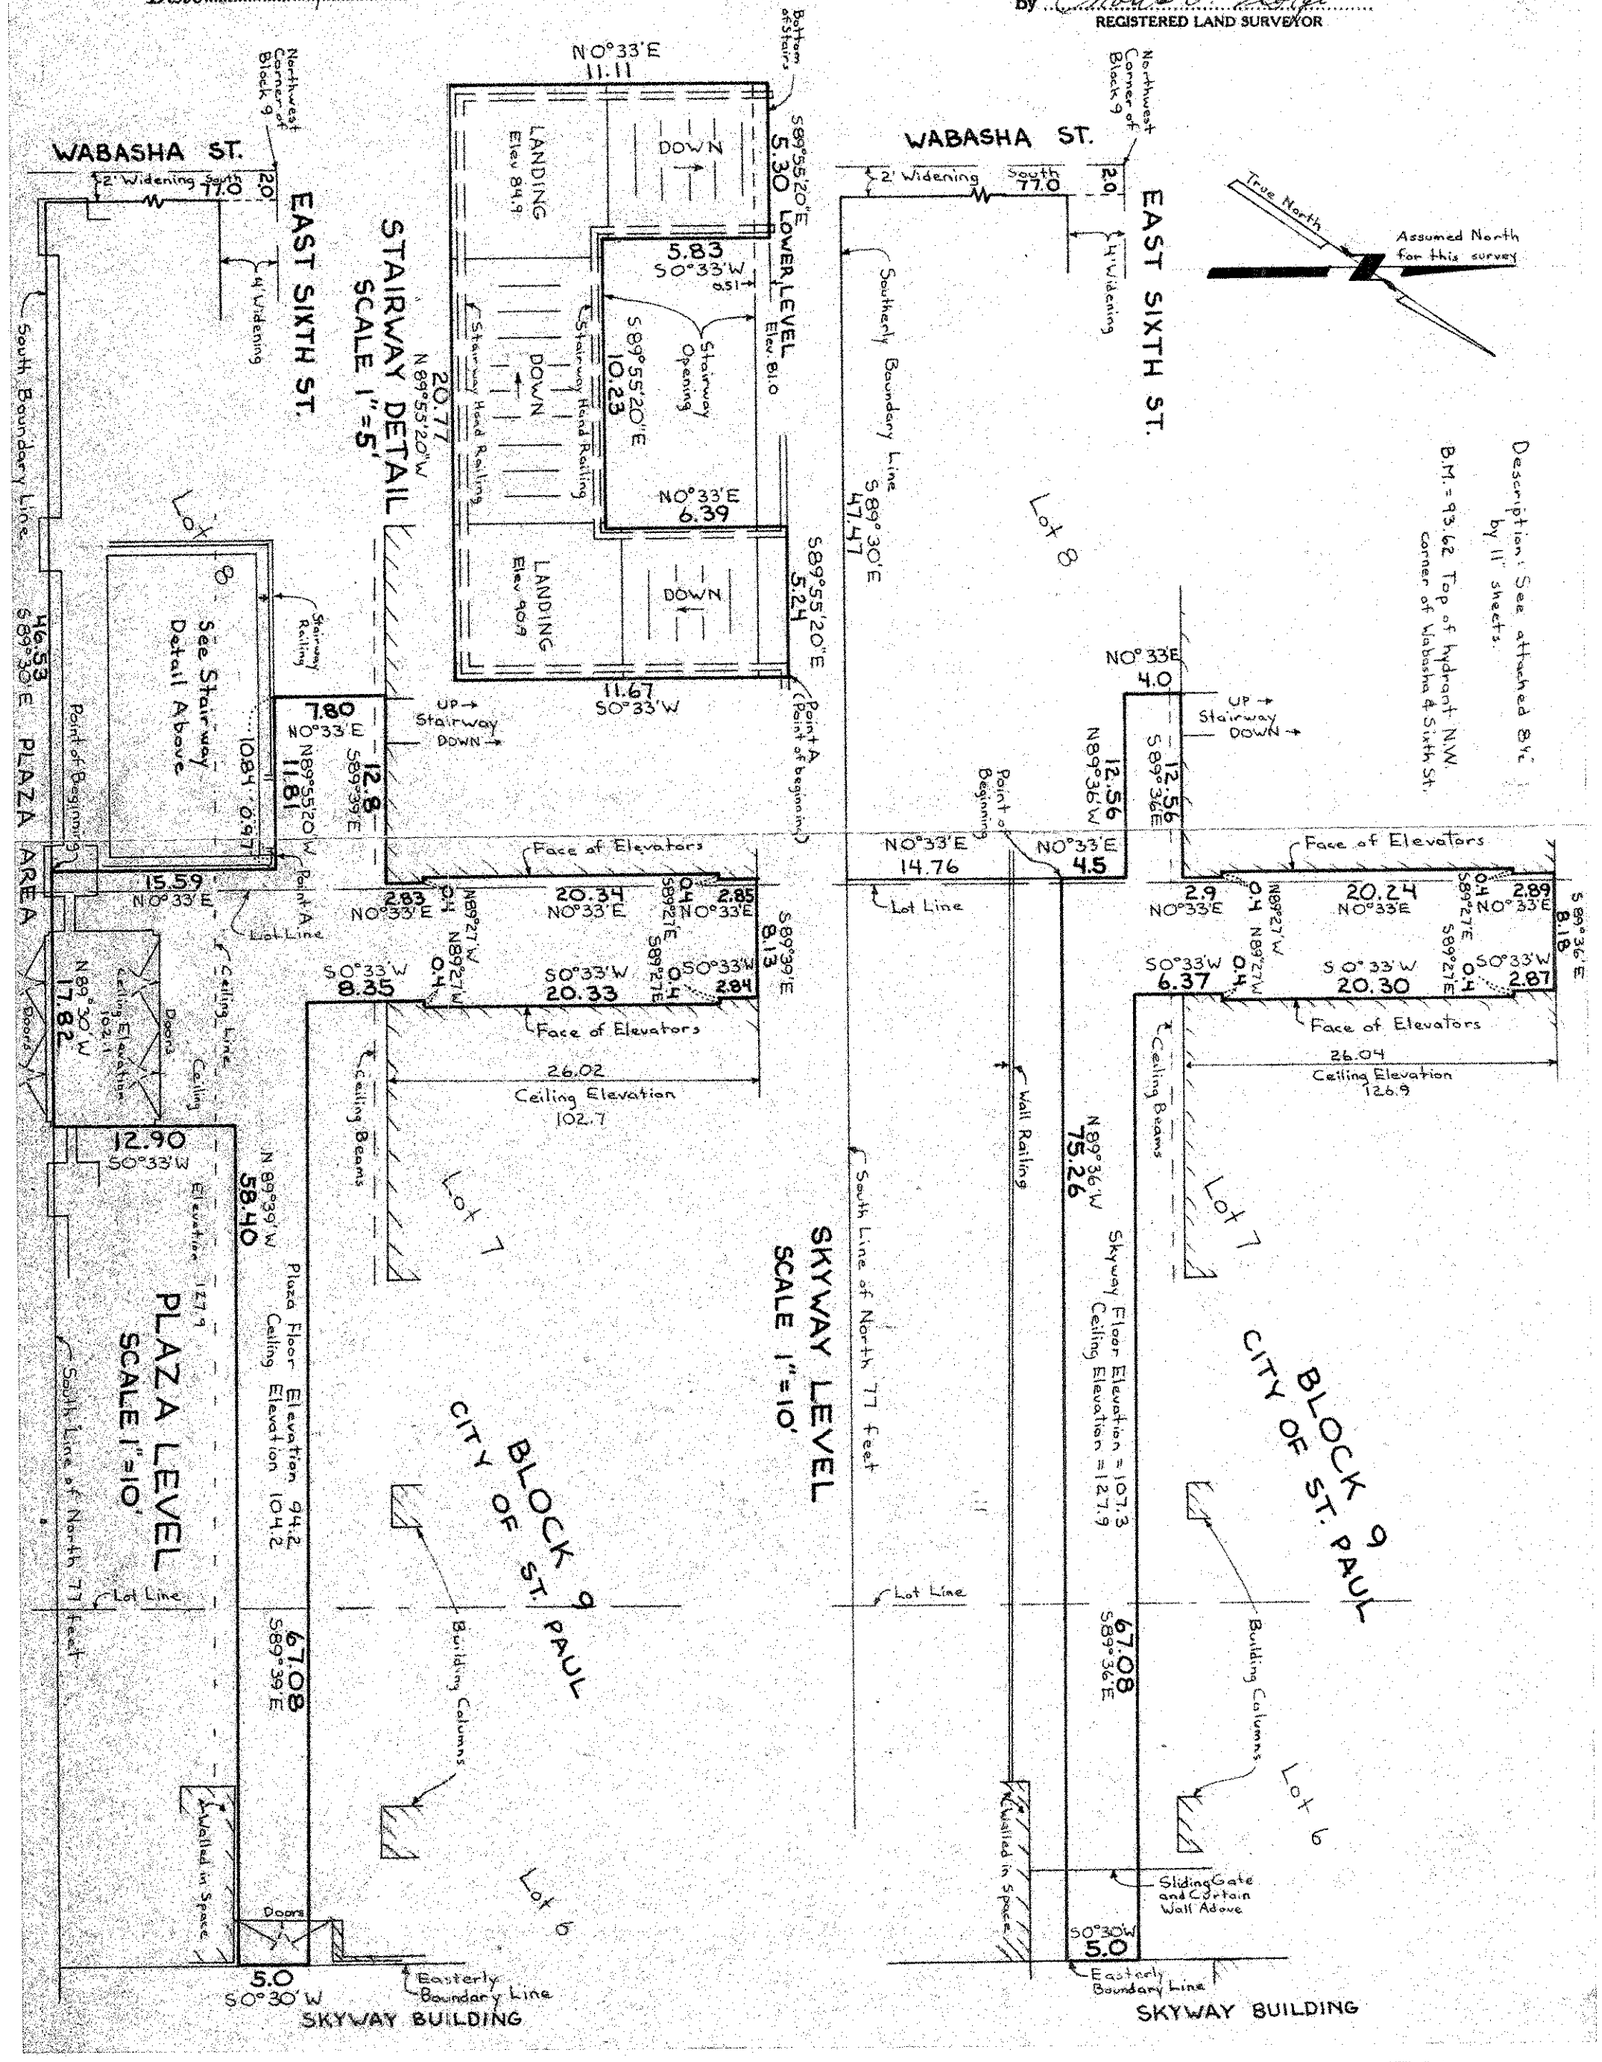
Date January 1975