


Copied May 28-1903.

6TH ST.

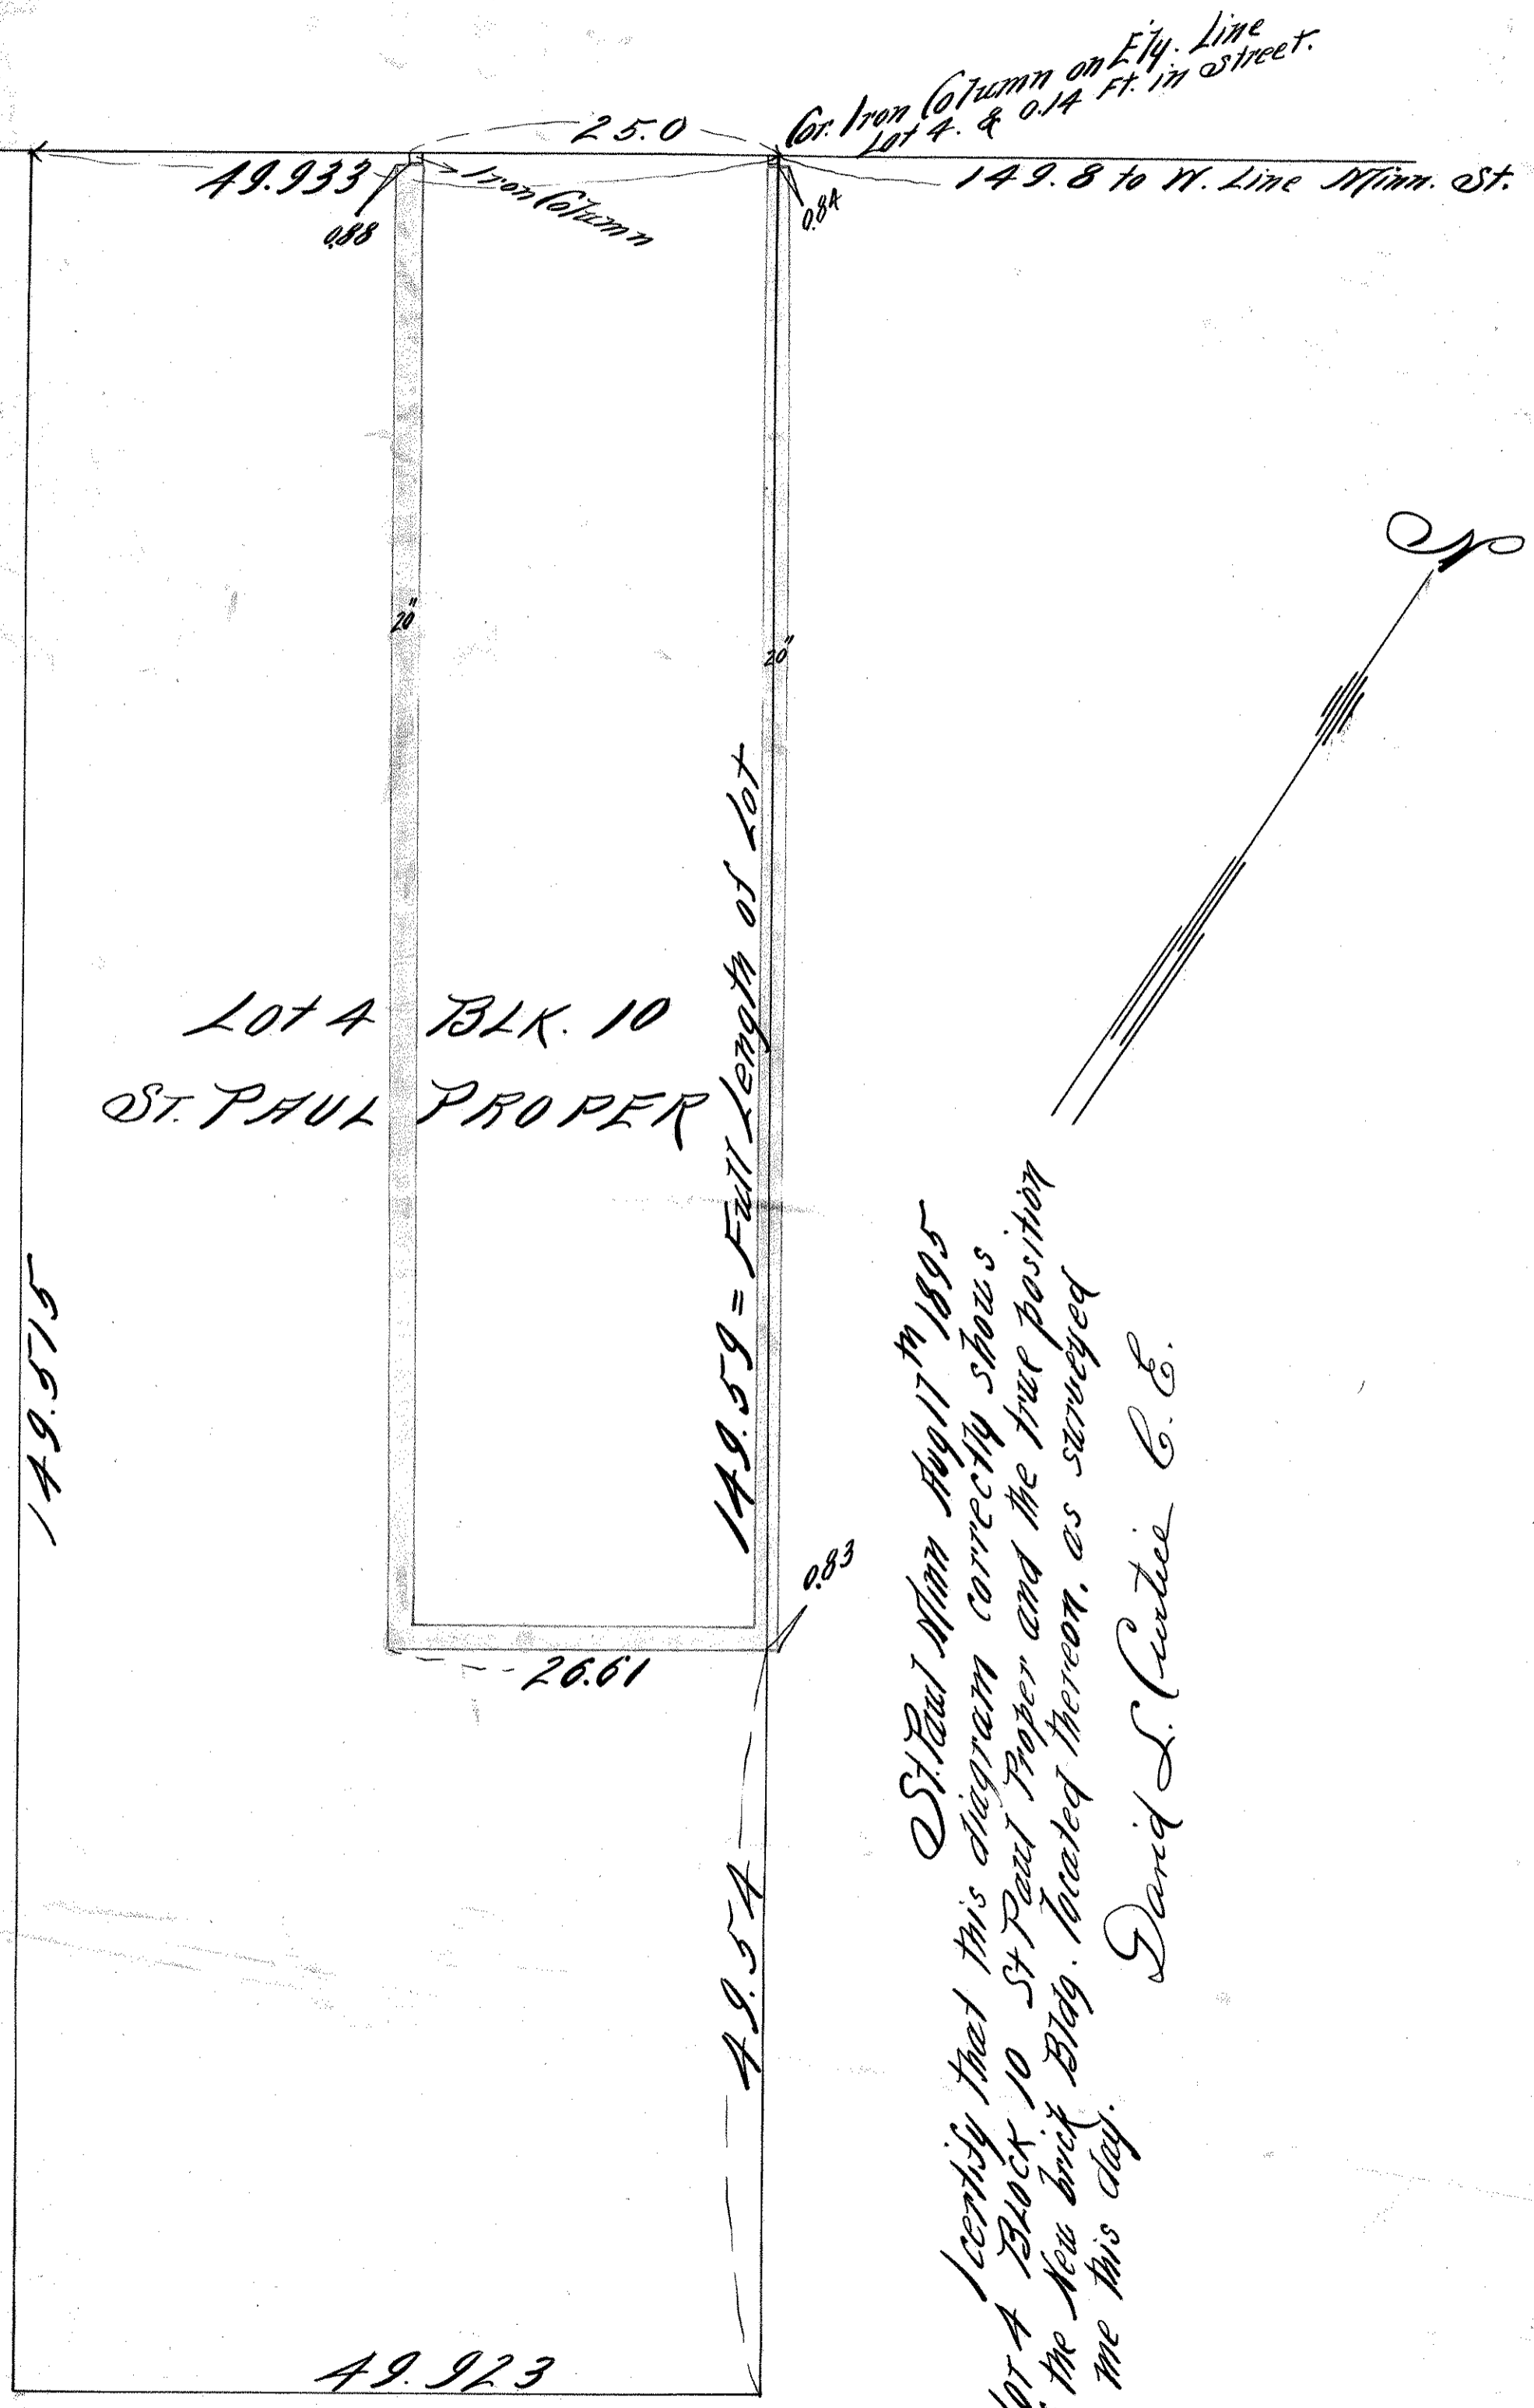

LOT A BLK. 10  
ST. PAUL PROPER

St. Paul Minn Aug 17<sup>th</sup> 1895  
I certify that this diagram correctly shows  
Lot A Block 10 St Paul Proper and the true position  
of the New brick Bldg. located thereon, as surveyed  
by me this day.

David L. Curtice C. E.