

Certificate of Survey


From the office of
GEORGI-SCHMIDT & ASSOC. INC.
3092 No. Lexington Ave., Roseville, Mn. 55113
LAND SURVEYING
483-4408

I Herby Certify that this plat shows a survey made by me of the property described on this plat, and that the corners are correctly placed as shown, and that all locations have been correctly shown.


8-20-81 Add E. Bridge data

Job Number: 981
Surveyed For Housing Authority
Date July 1981


Paul W. Schmidt
A.L.S. #10459

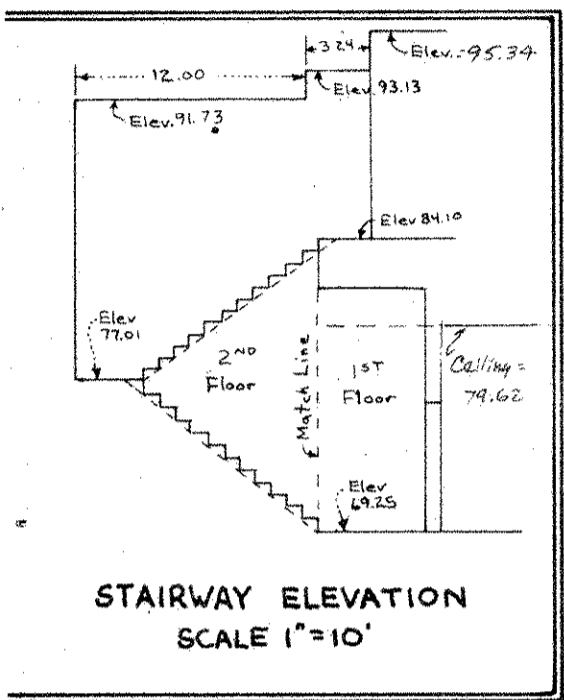

STAIRWAY ELEVATION
SCALE 1"=10'

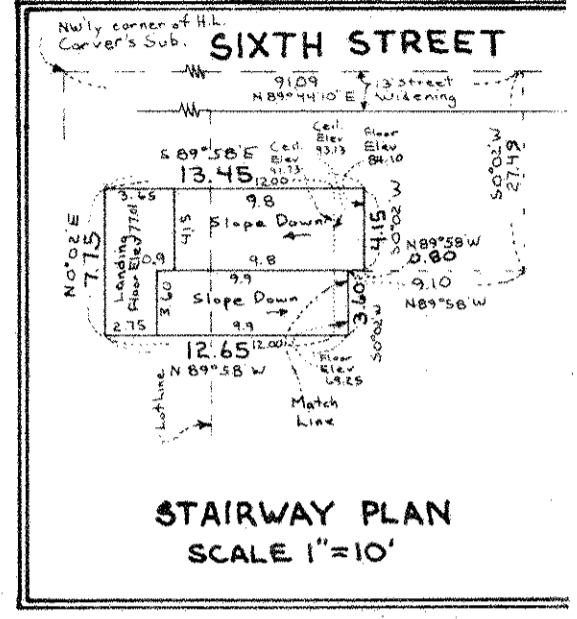

STAIRWAY PLAN
SCALE 1"=10'

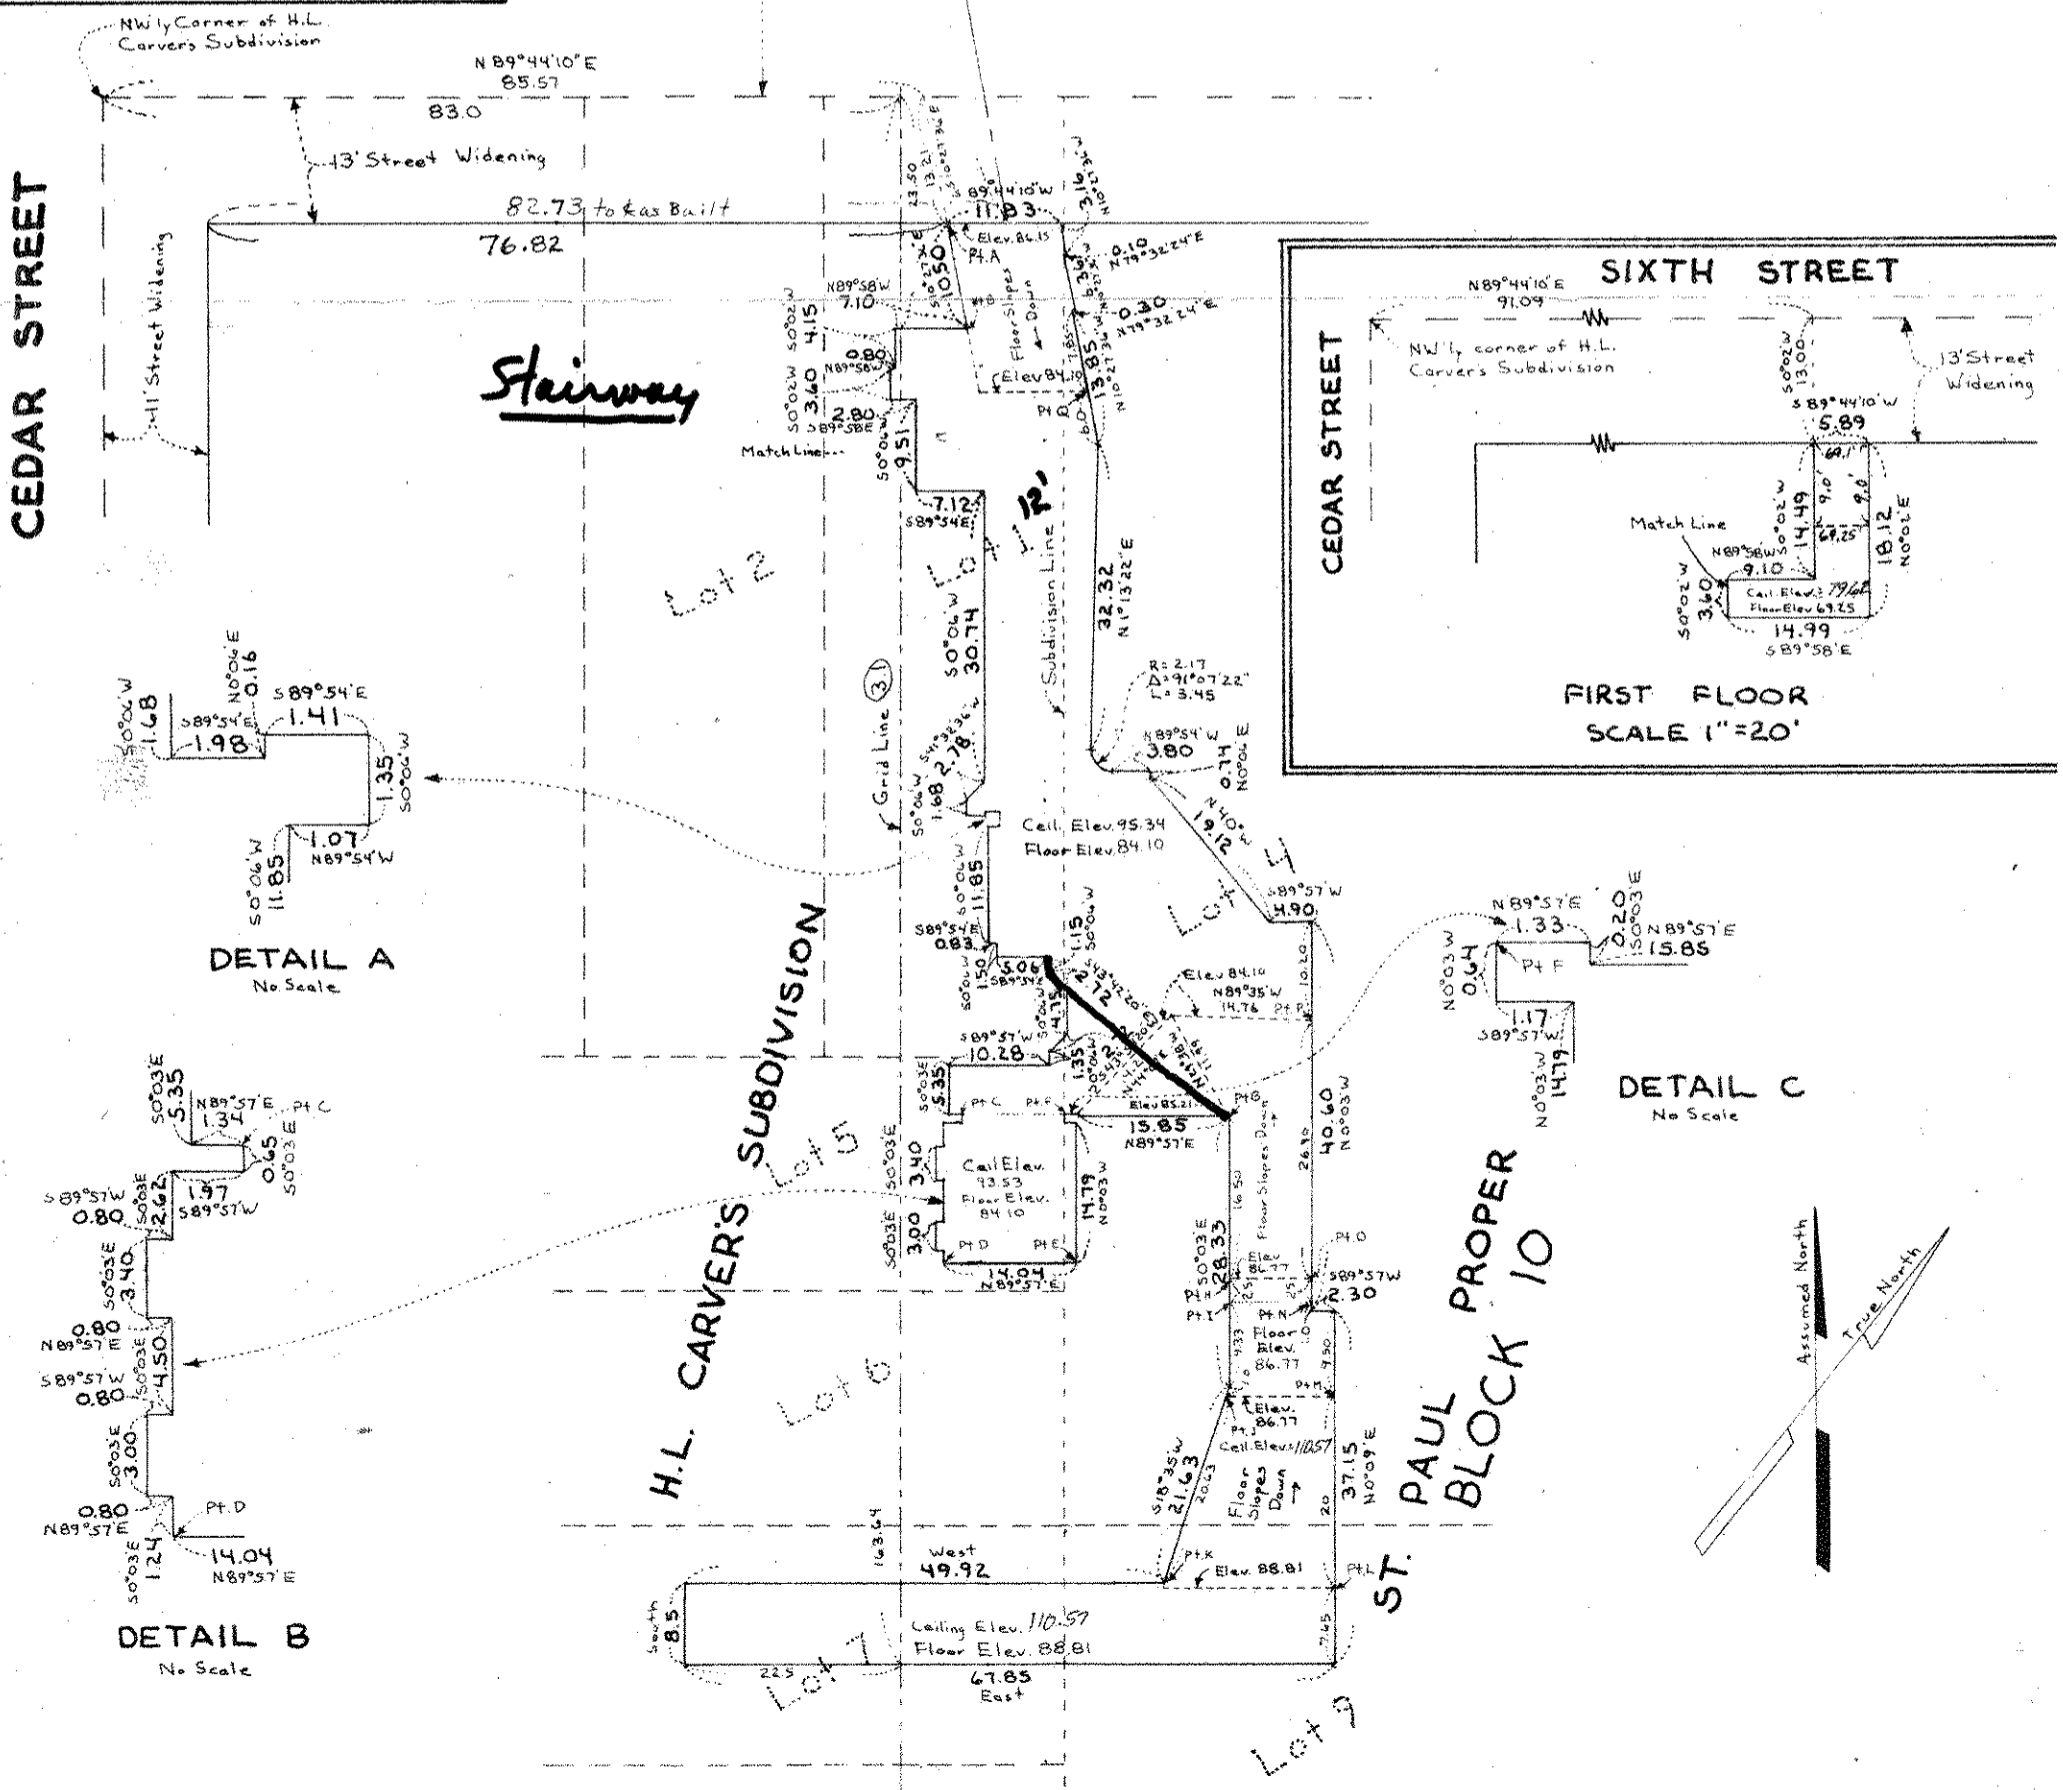

CEDAR STREET

SIXTH STREET

CEDAR STREET

SIXTH STREET

FIRST FLOOR
SCALE 1"=20'

SECOND FLOOR
SCALE 1"=20'

DETAIL C
No Scale

DETAIL A
No Scale

DETAIL B
No Scale

