

Certificate of Survey

From the office of
GEORGI-SCHMIDT & ASSOC. INC.

3092 No. Lexington Ave., Roseville, Mn. 55113


LAND SURVEYING

483-4408


I Hereby Certify that this plat shows a survey made by me of the property described on this plat, and that the corners are correctly placed as shown, and that all locations have been correctly shown.

Job Number: 981
Surveyed For Housing Authority
Date July 1981

*MAKE UP
NOT FINAL*

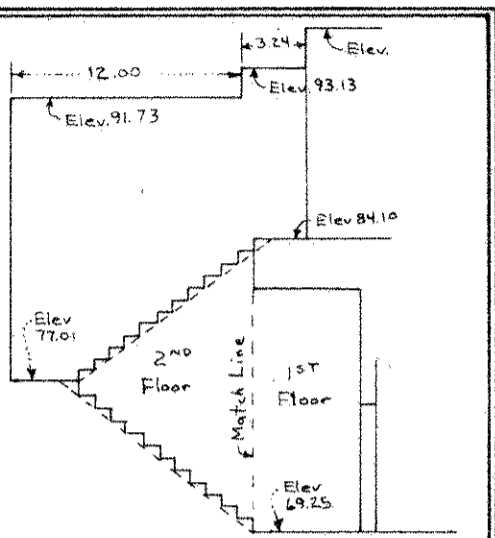


STAIRWAY ELEVATION
SCALE 1"=10'

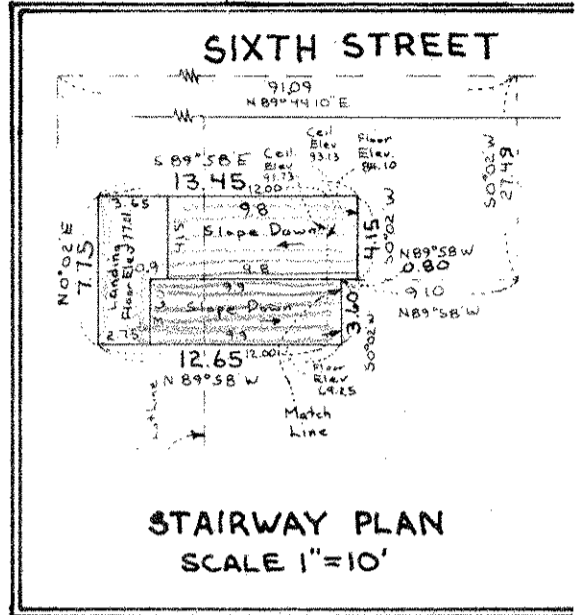

STAIRWAY PLAN
SCALE 1"=10'

SIXTH STREET

FLOOR

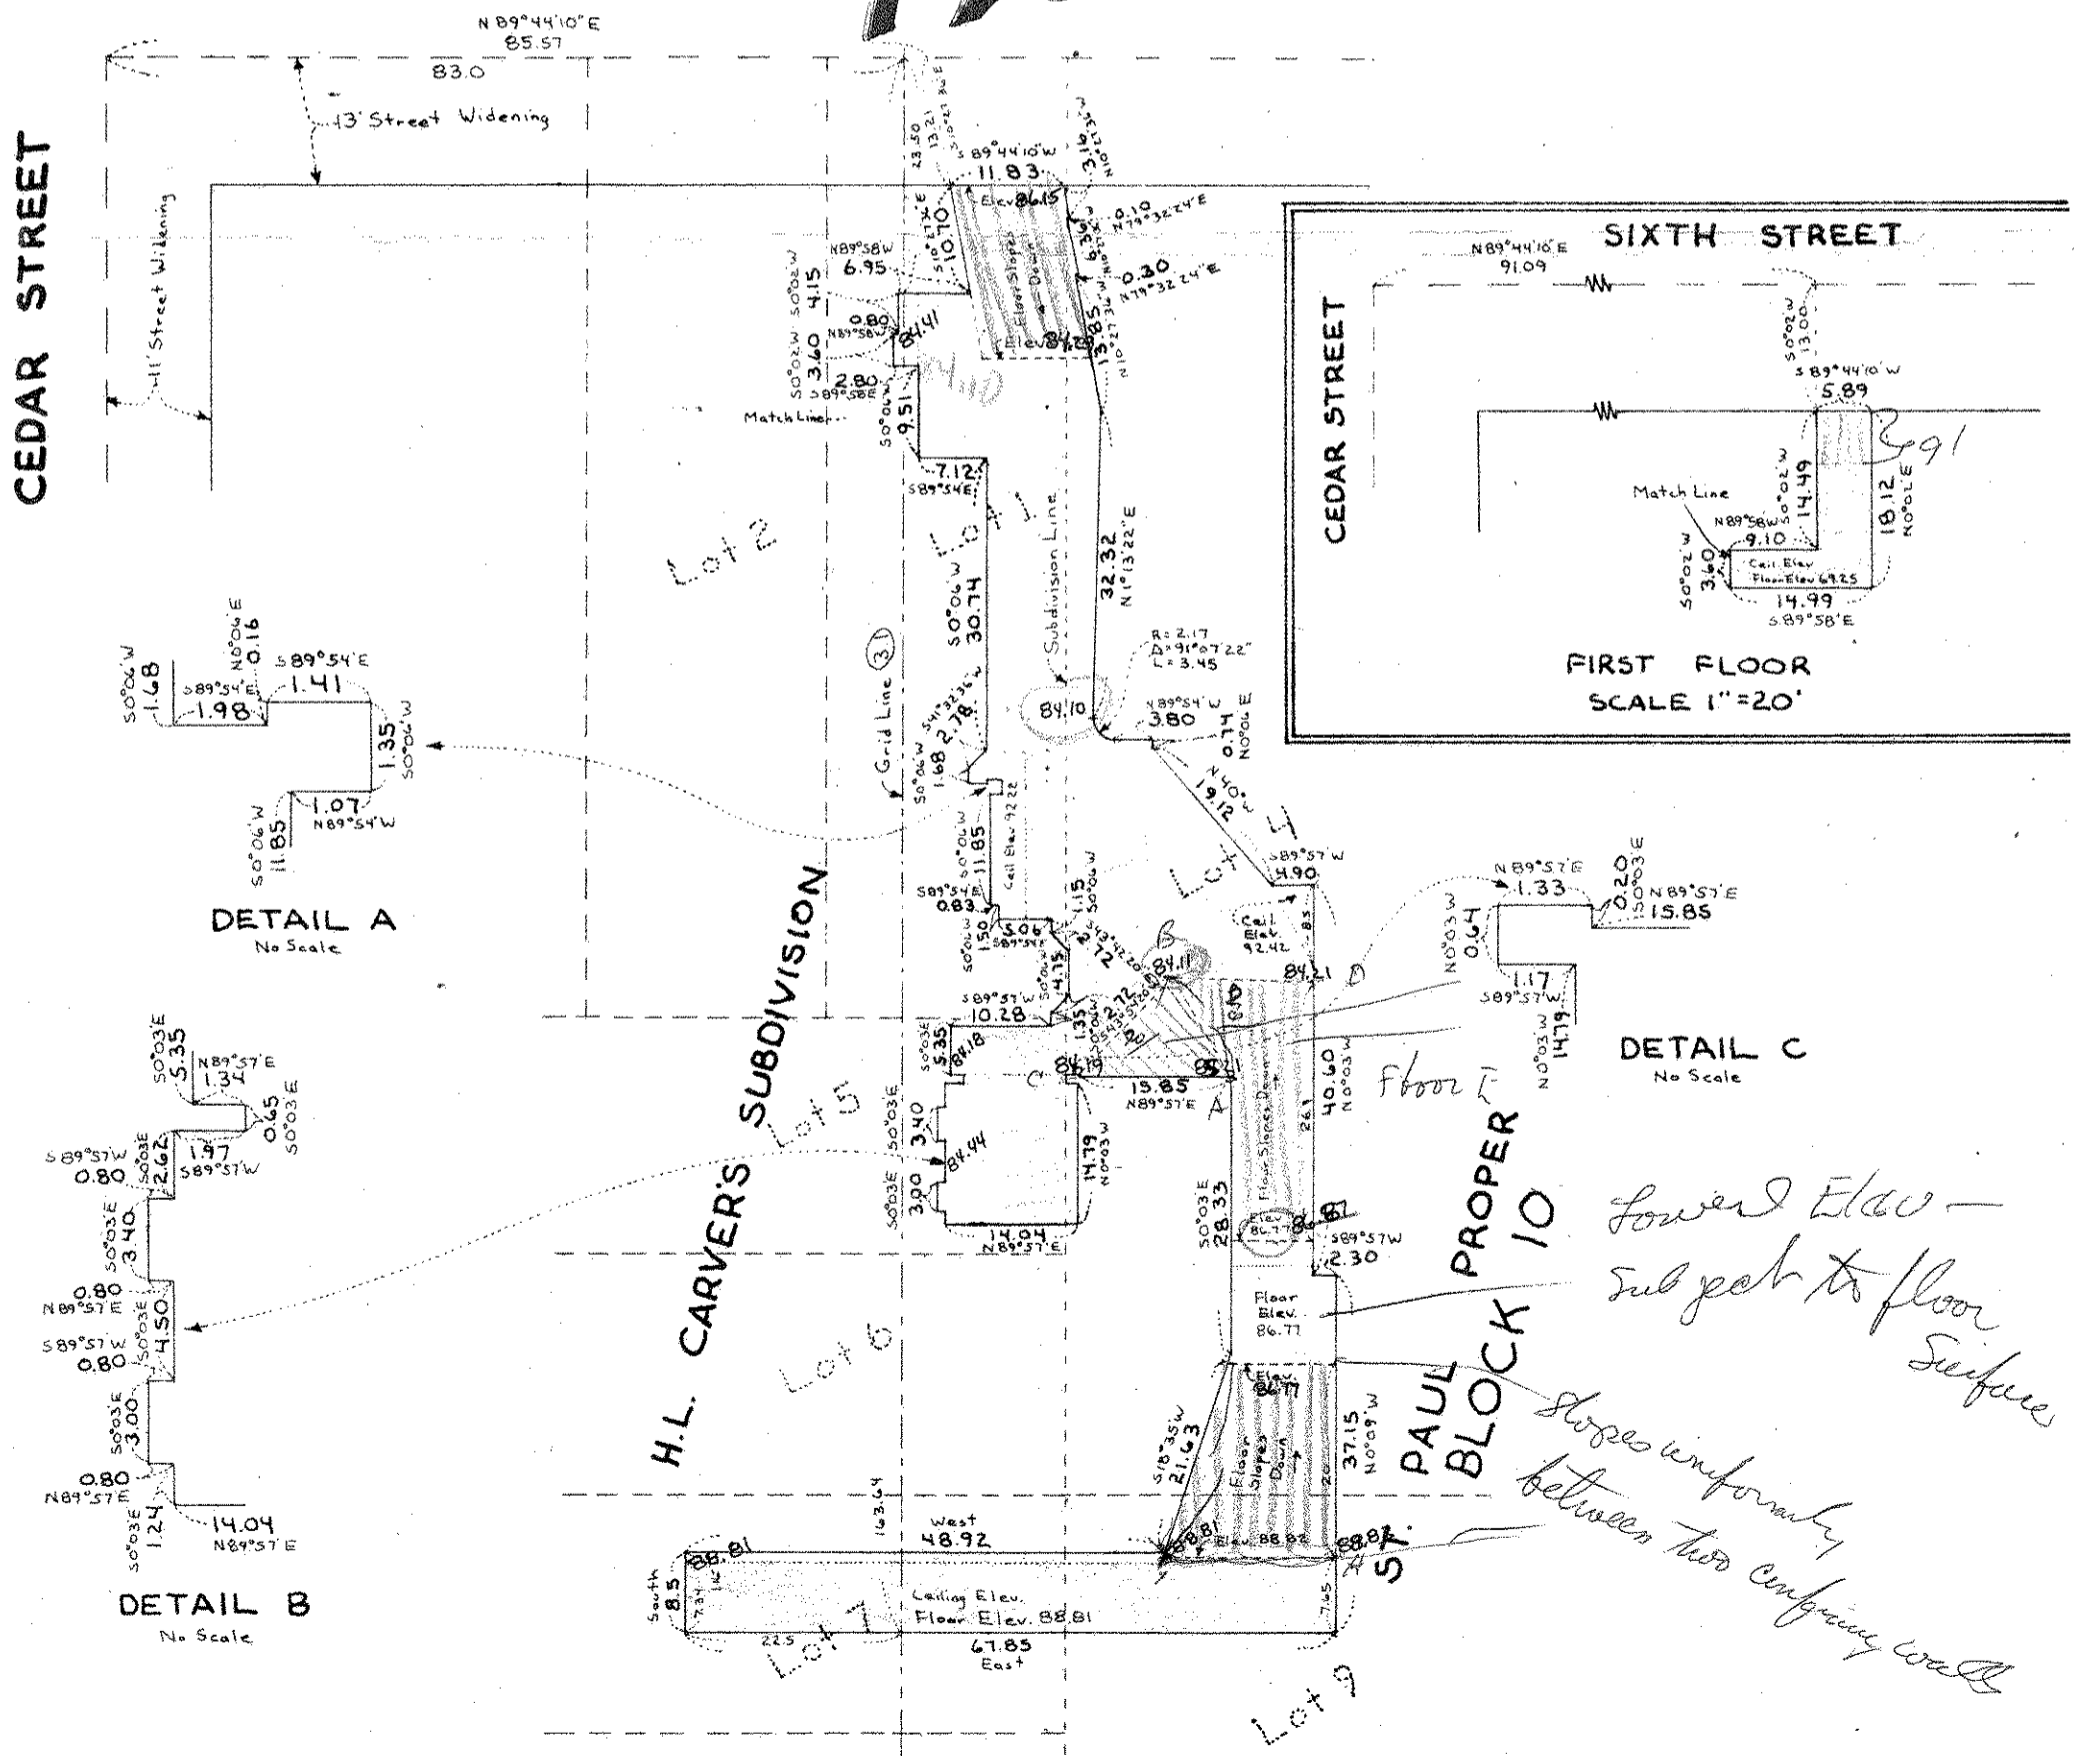

DETAIL A
No Scale

DETAIL B
No Scale

DETAIL C
No Scale

SECOND FLOOR
SCALE 1"=20'

*Lower Elev -
subject to floor
Surfaces
Slopes uniformly
between two adjoining walls*

**PAUL
BLOCK
10**

**H.L. CARVER'S
SUBDIVISION**