FROM THE OFFICE OF

CHARLES O. GEORGI COMPANY

2215 West County Road B Saint Paul 8, Minnesota

MINNESOTA REGISTERED LAND SURVEYOR

Certificate of Survey

Sheet 1

I Hereby Certify that this plat shows a survey made by me of the property described on this plat, ~~and that the corners are correctly placed as shown~~, and that all locations, encroachments, etc., have been correctly shown.

6/23/70 Added Ellipse Area

Surveyed For ..... Housing Authority — Grover Dimond Assoc.

Date ..... June 1969

Scale ..... 1" = 10'

Note: See attached sheets for description

By ..... Charles O. Georgi
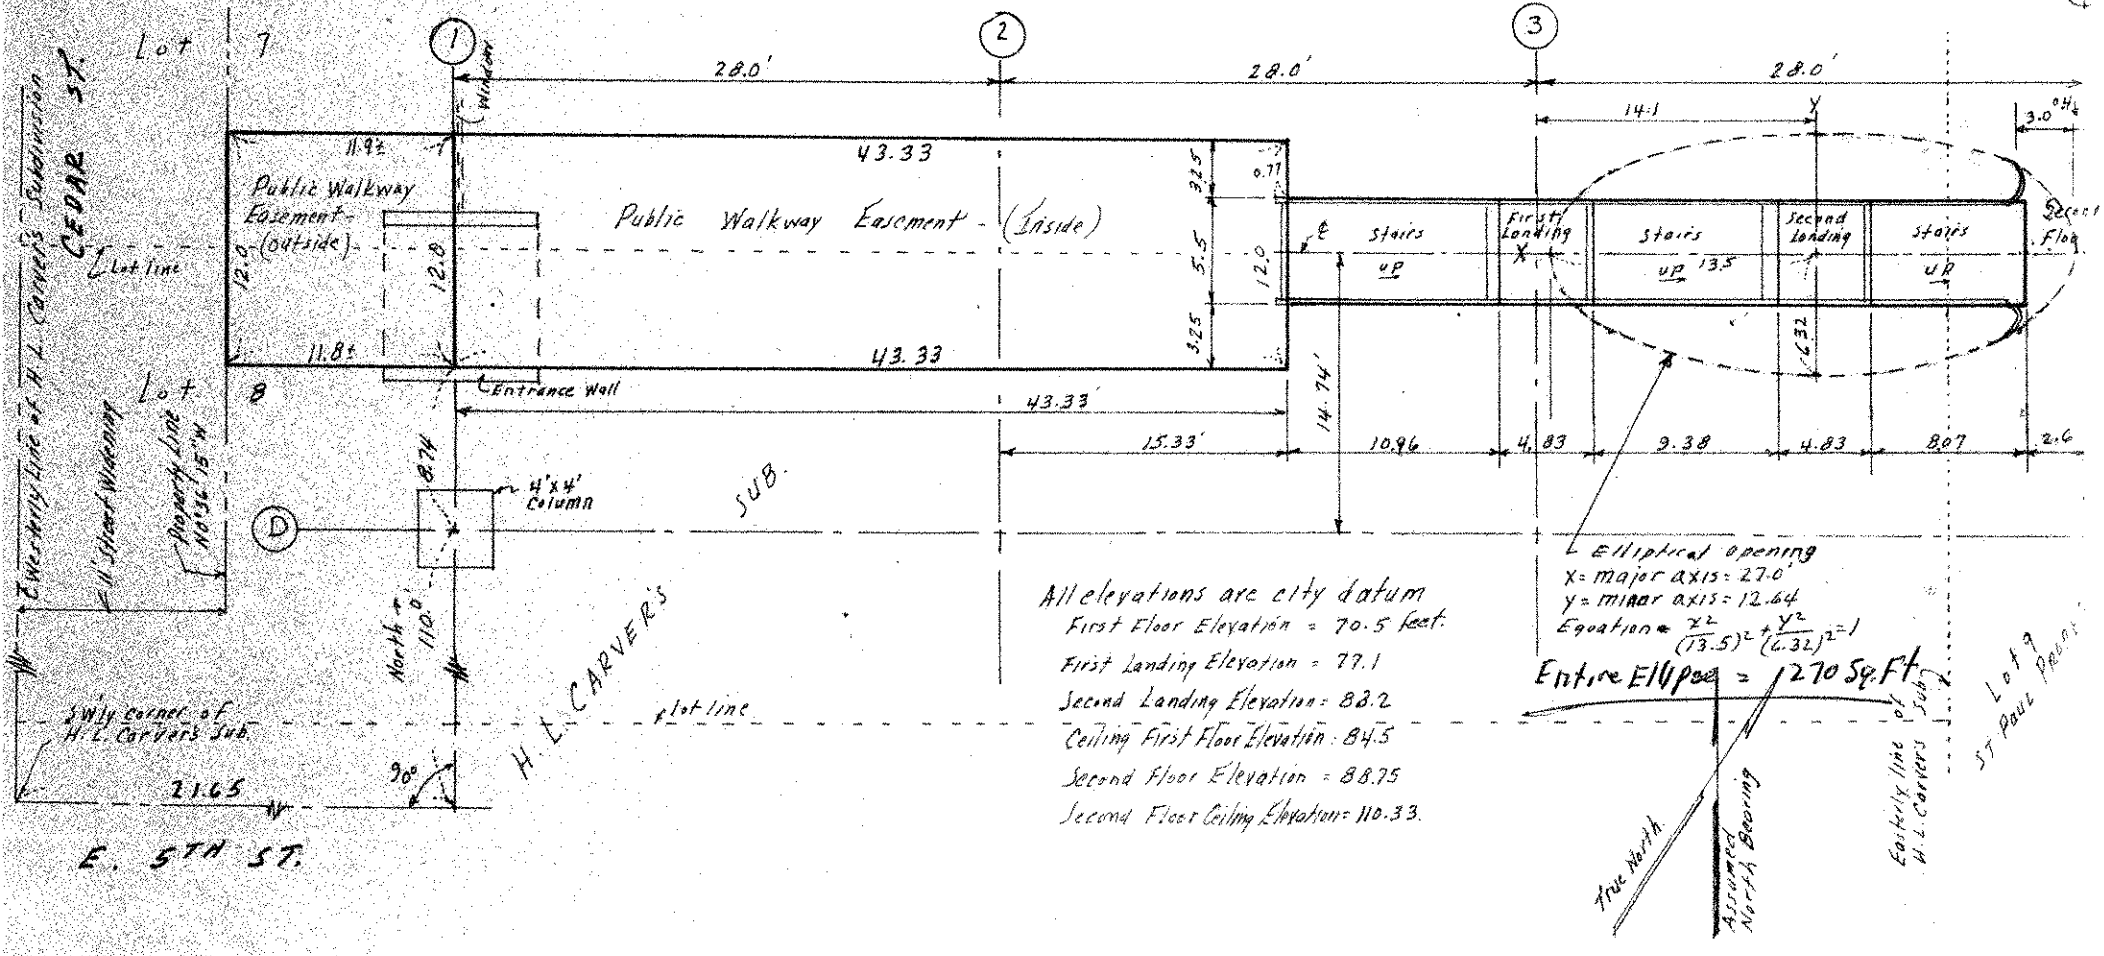
REGISTERED LAND SURVEYOR