Certificate of Survey

From the office of

GEORGI- SCHMIDT & ASSOC. INC.

3092 No. Lexington Ave., Roseville, Minn.

LAND SURVEYING

483-4408

I Hereby Certify that this plat shows a survey made by me of the property described on this plat.

Job Number: 1291

Surveyed For N.W. National Bank

Date November 1982

By _____

REGISTERED LAND SURVEYOR.

#10459

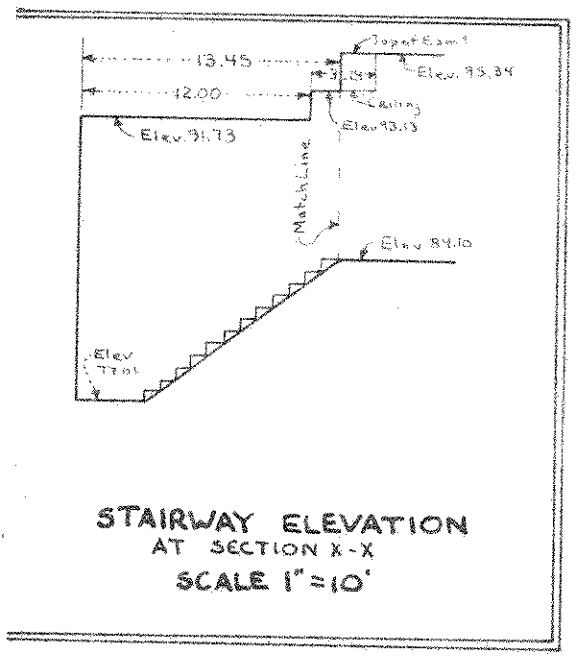

STAIRWAY ELEVATION
AT SECTION X-X
SCALE 1"=10'

STAIRWAY ELEVATION
AT SECTION Z-Z
SCALE 1"=10'

SECOND FLOOR

SCALE: 1" = 20'

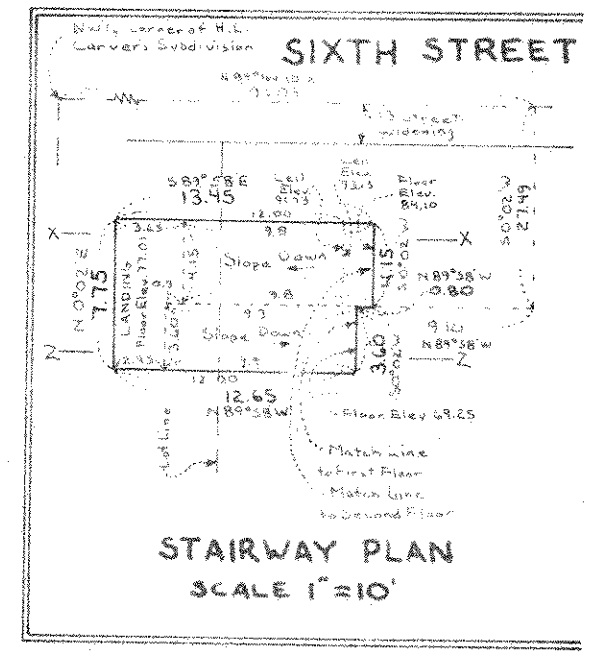

STAIRWAY PLAN
SCALE 1"=10'

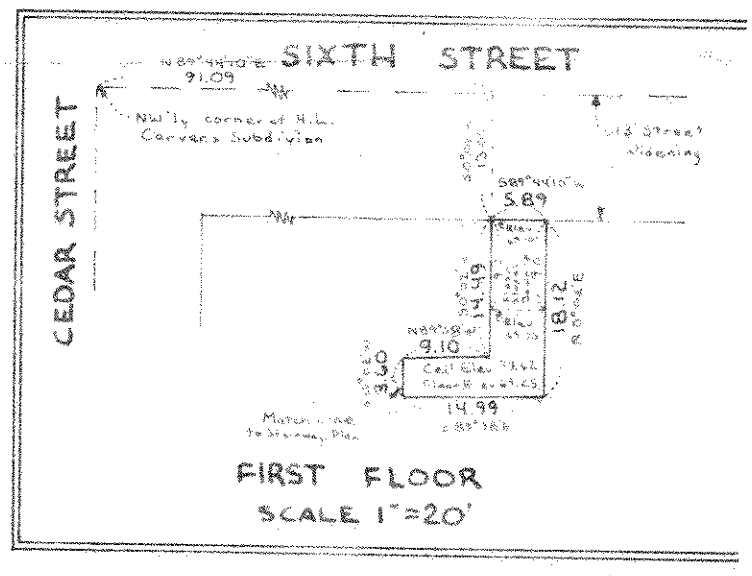

FIRST FLOOR
SCALE 1"=20'